



BATTER WALL OPTION - GEOGRID NOT ANTICIPATED FOR BATTER OPTION 2

PARE MARK-UP
2024-02-14
NOT FOR CONSTRUCTION

HKT
architects inc.
24 Roland Street,
Suite 301
Charlestown, MA 02129
T: 617.776.6545
F: 617.776.6678
www.hktarchitects.com

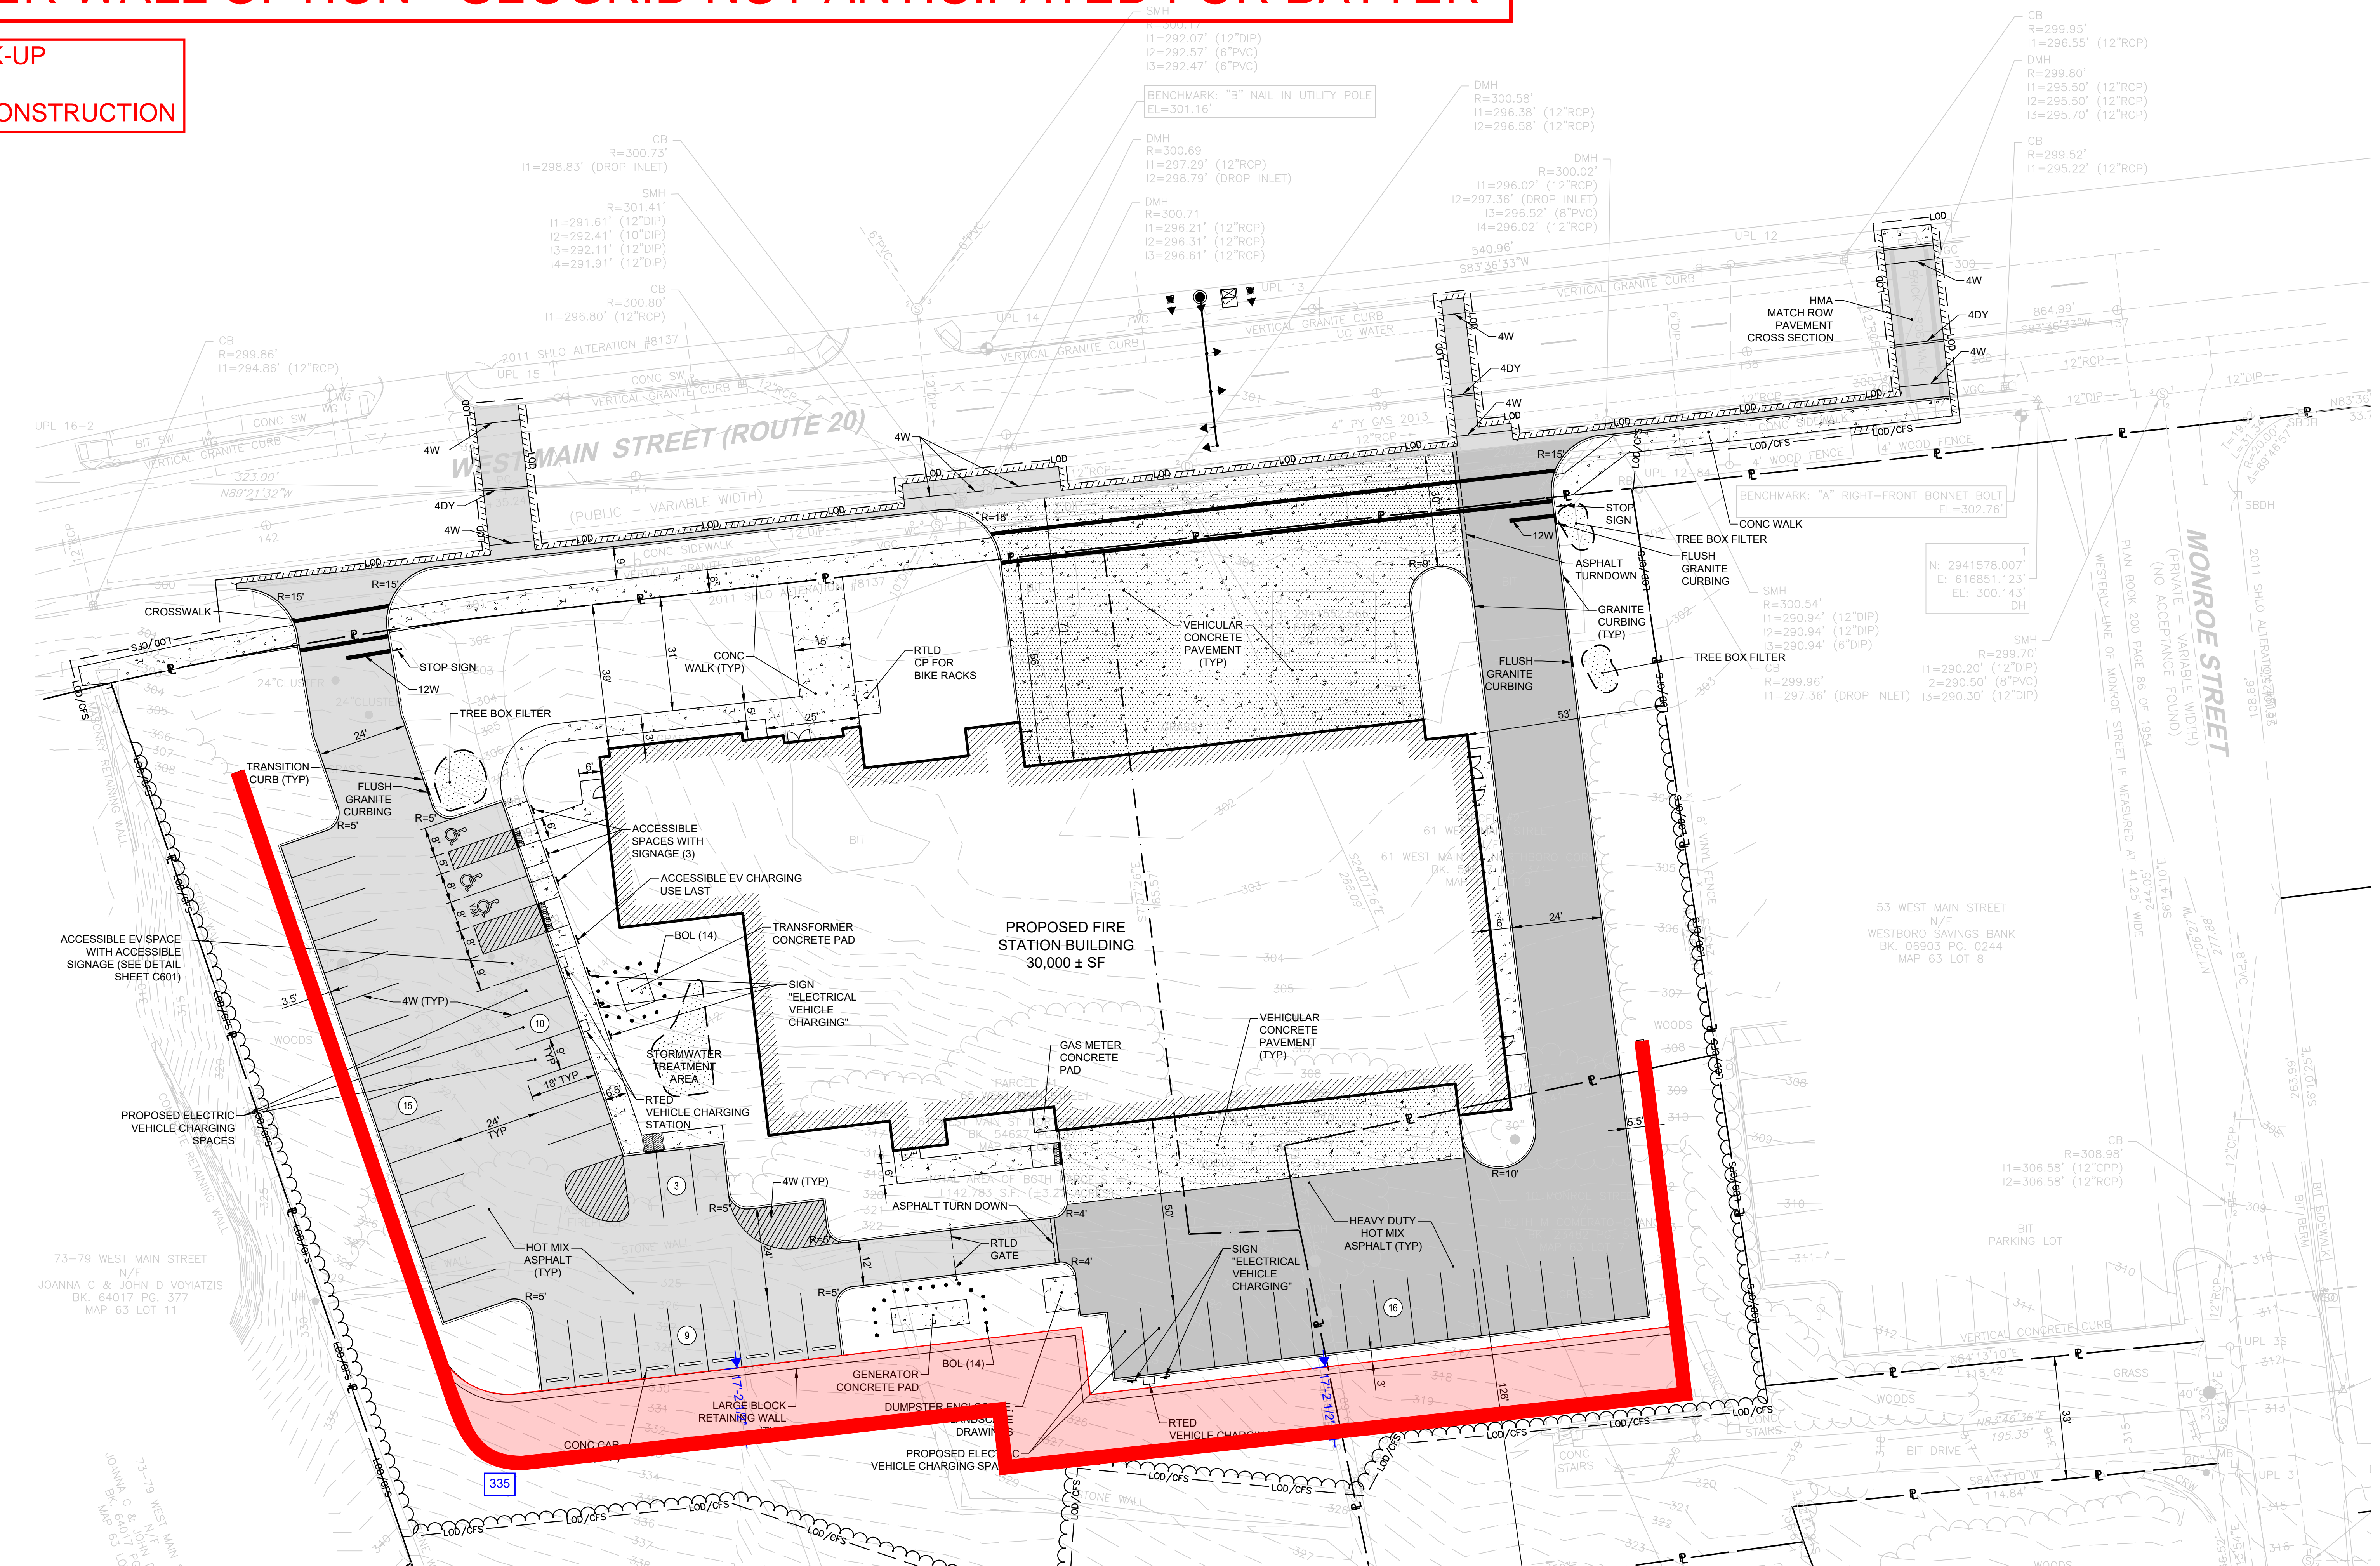

- NOTES:**
- CONTRACTOR SHALL PROVIDE LOAM AND SEED ON ALL DISTURBED AREAS UNLESS NOTED OTHERWISE. REFER TO LANDSCAPE DRAWINGS FOR SURFACE COVER IN LANDSCAPED AREAS.
 - ALL ACCESSIBLE RAMPS SHALL BE CONSTRUCTED WITH DETECTABLE WARNING PAVERS.
 - PRIOR TO COMMENCING WORK, THE CONTRACTOR SHALL EMPLOY A PROFESSIONAL LAND SURVEYOR REGISTERED IN THE STATE OF RHODE ISLAND TO ESTABLISH CONTROL ON THE SITE AND TO PERFORM FIELD MEASUREMENTS AS REQUIRED TO LAYOUT THE PROPOSED BUILDING AND SITE IMPROVEMENTS. THE CONTRACTOR'S SURVEYOR SHALL COORDINATE THE BUILDING LAYOUT WITH THE PROJECT LAND SURVEYOR TO ACCURATELY LOCATE THE BUILDING ON THE SITE.
 - REFER TO STRUCTURAL DRAWINGS FOR ALL CONCRETE ENTRANCE PADS.
 - REFER TO STRUCTURAL DRAWINGS FOR ALL TYPICAL SECTIONS OF ENTRY WAYS.
 - EXPANSION JOINTS (E.J.) 20 FEET O.C. (MAX.) UNLESS OTHERWISE NOTED.
 - CONTROL JOINTS (C.J.) 5 FEET O.C. (MAX.) UNLESS OTHERWISE NOTED.
 - ALL PARKING SPACES AND ISLANDS ARE TO BE MARKED WITH 4" THICK WHITE EPOXY PAVEMENT MARKING UNLESS NOTED OTHERWISE. WATERBORNE PAVEMENT MARKINGS ARE NOT ACCEPTABLE.
 - COORDINATE FINAL QUANTITY AND PLACEMENT OF BOLLARDS SURROUNDING TRANSFORMER WITH NATIONAL GRID.
 - COORDINATE FINAL QUANTITY AND PLACEMENT OF BOLLARDS SURROUNDING GENERATOR WITH ELECTRICAL DRAWINGS, UTILITY COMPANY, AND MANUFACTURER'S RECOMMENDATIONS.
 - COORDINATE ALL SIGN PLACEMENT AND SIZE WITH OWNER'S REPRESENTATIVE PRIOR TO INSTALLATION.
 - REFER TO "NOTES" FOR ADDITIONAL NOTES.

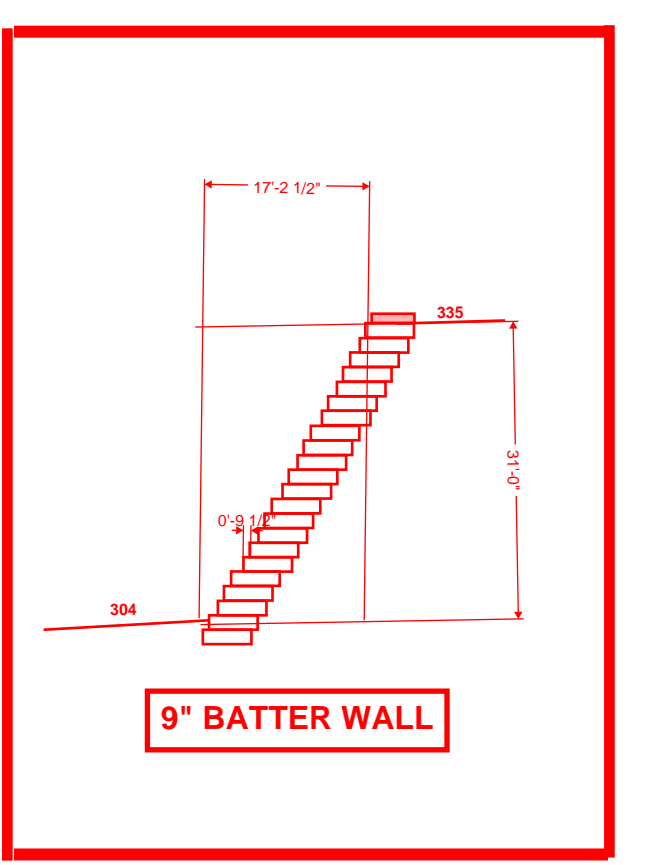

Revision Schedule

Number	Revision	Date

Registrations

Consultants
PARE
PARE CORPORATION
ENGINEERS - SCIENTISTS - PLANNERS
10 LINCOLN ROAD, SUITE 210
FOXBORO, MA 02835
508-943-1755

Project
NORTHBOROUGH FIRE STATION
63 WEST MAIN STREET
TOWN OF NORTHBOROUGH, MA

GENERAL PLAN

AKL NC
Drawn by: 2/14/2024
Checked by:
Date: 23141.00 1" = 20'
Job number:
DRAFT ADVANCED SCHEMATIC DESIGN
Drawing set

Scale: 1"=20'
0 10' 20' 40'

C-300

Revision Schedule		
NO.	Revision	Date

Registrations

Consultants


Project
NORTHBOROUGH FIRE STATION
63 WEST MAIN STREET
TOWN OF NORTHBOROUGH, MA

Drawing Title
BATTERWALL

Author
Drawn by
1/31/2024
Date
22314
Job number
SCHEMATIC DESIGN PRICING
Drawing set

Drawing number


OPT - 2

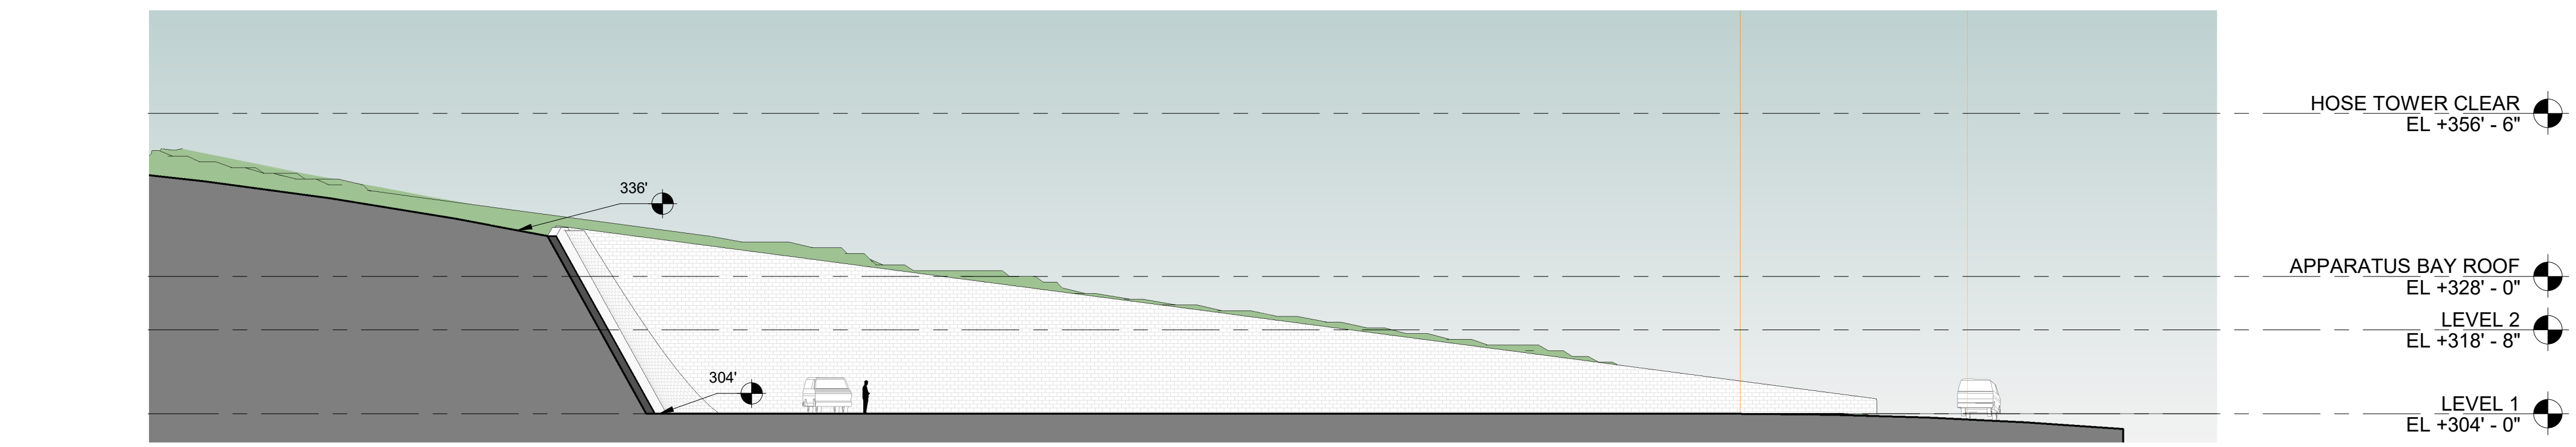

SECT. AA BATTERWALL WEST

1" = 20'-0"


4

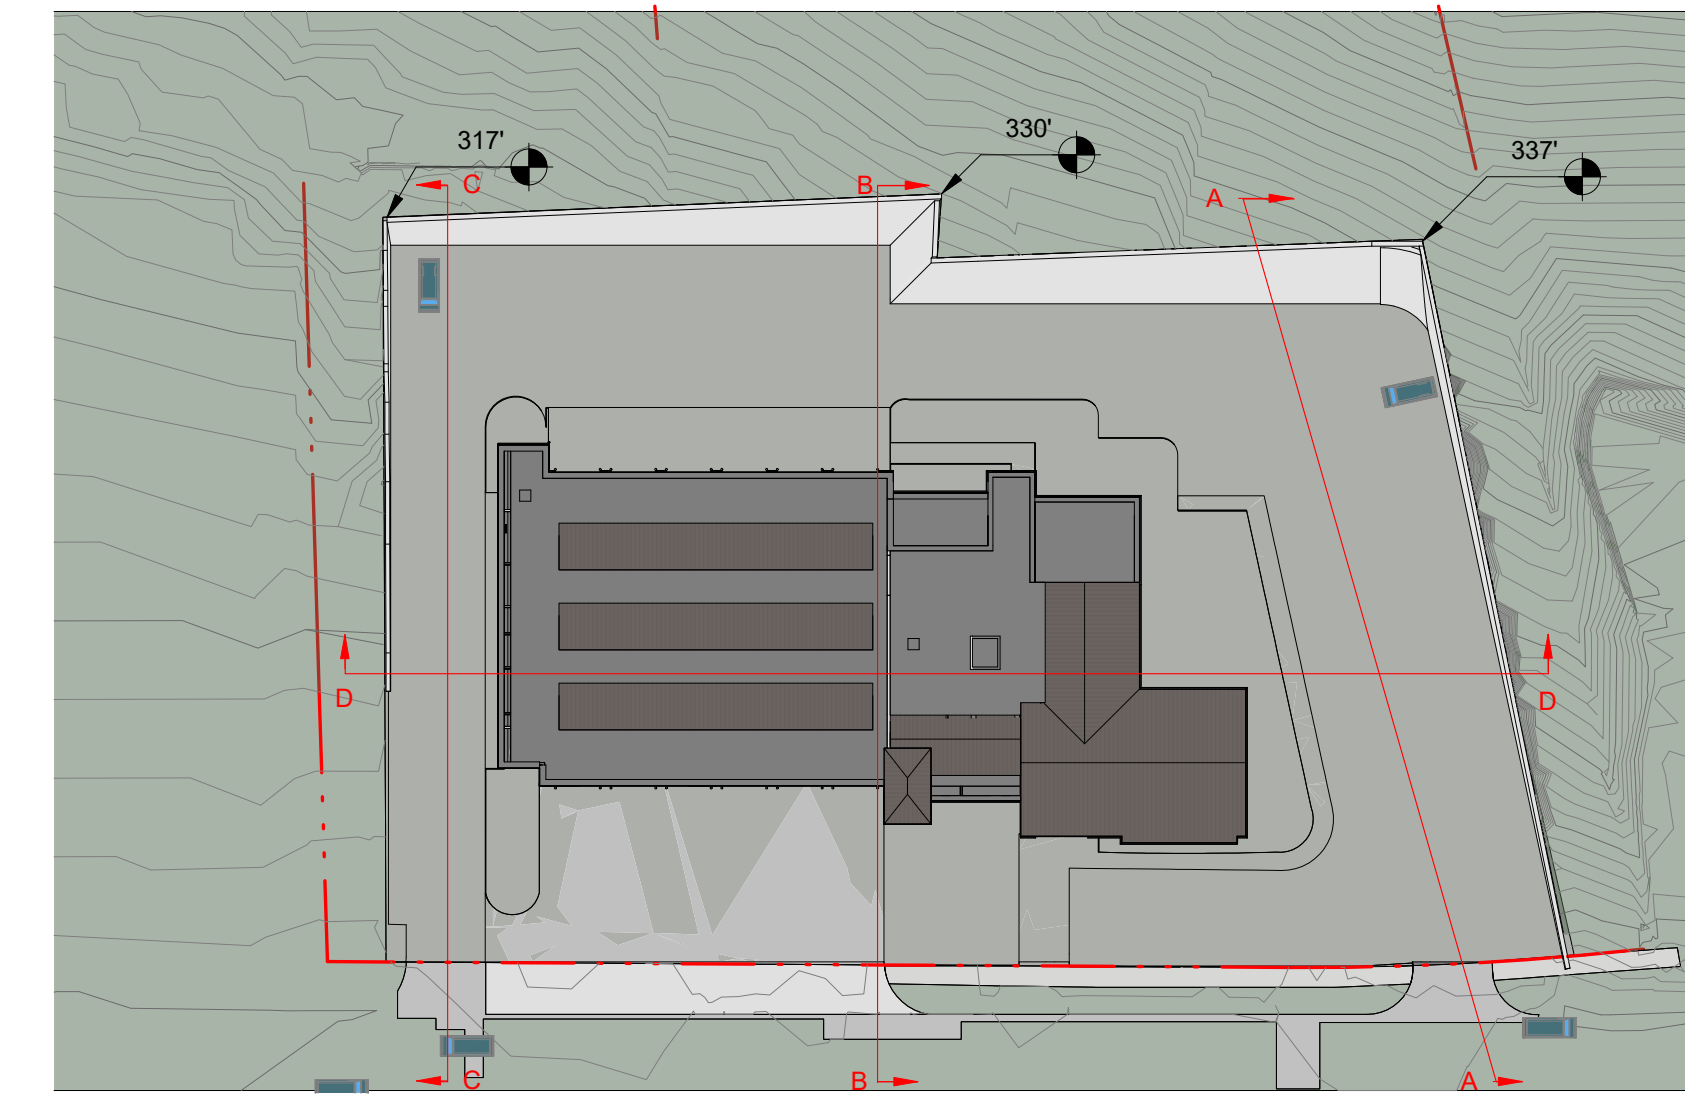

SITE PLAN OPTION 2 BATTERWALL

1" = 60'-0"


5

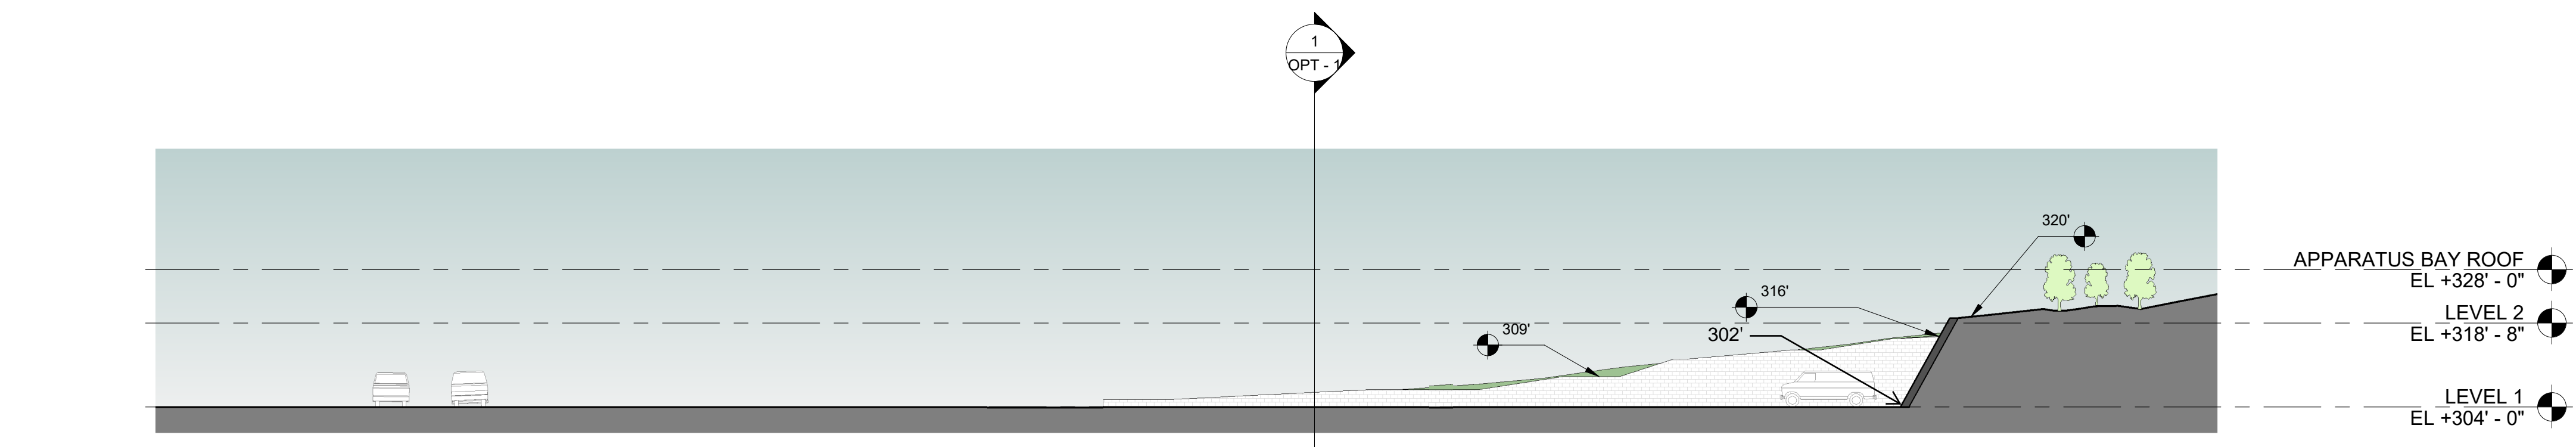

SECT. CC BATERWALL EAST

1" = 20'-0"


3

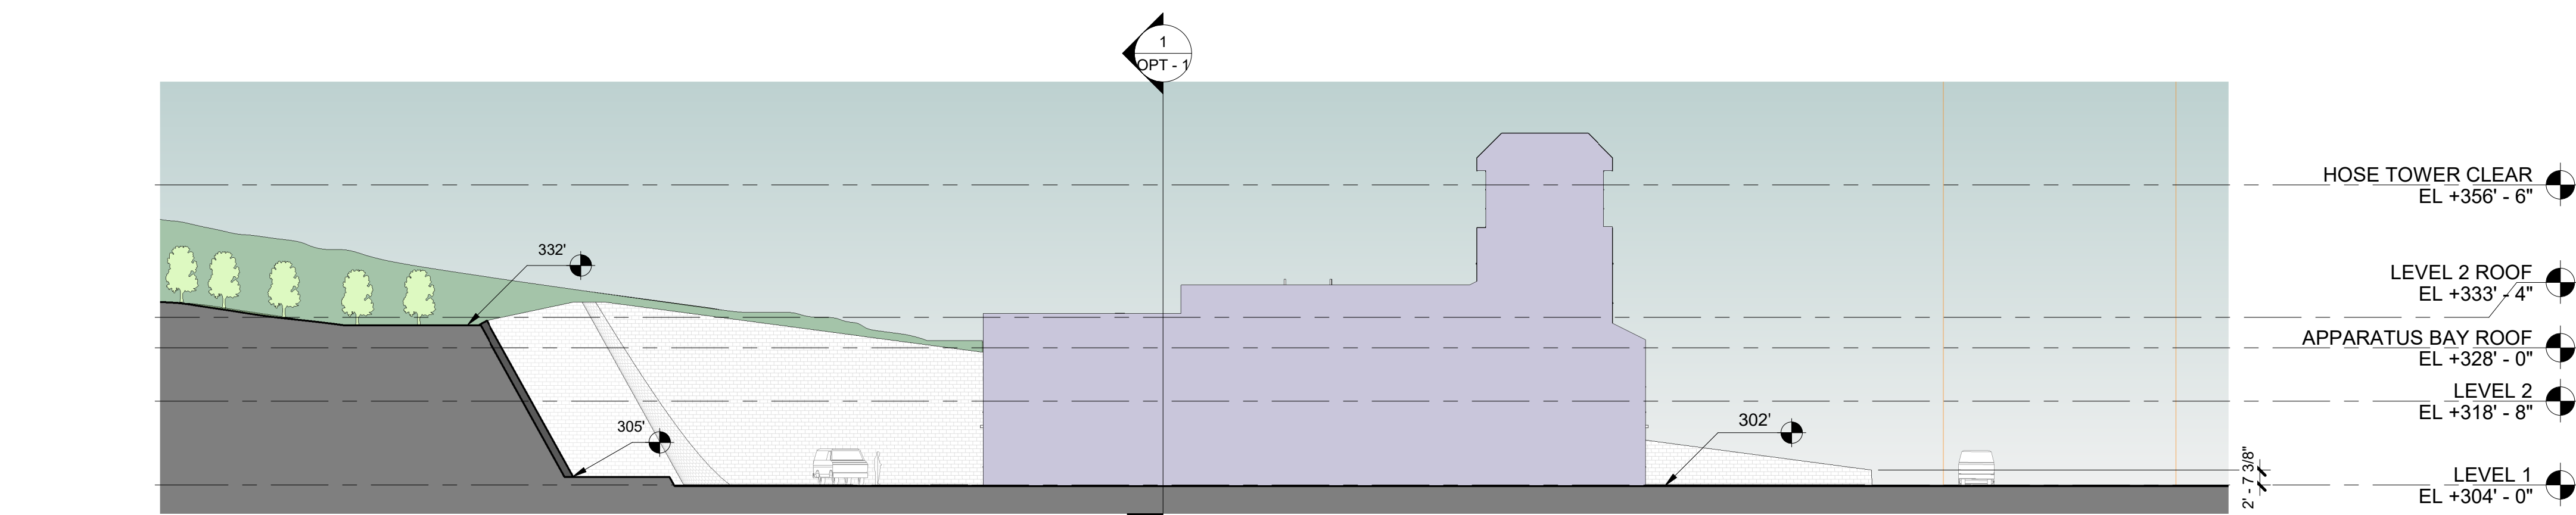

SECT. BB BATTERWALL MID

1" = 20'-0"

2

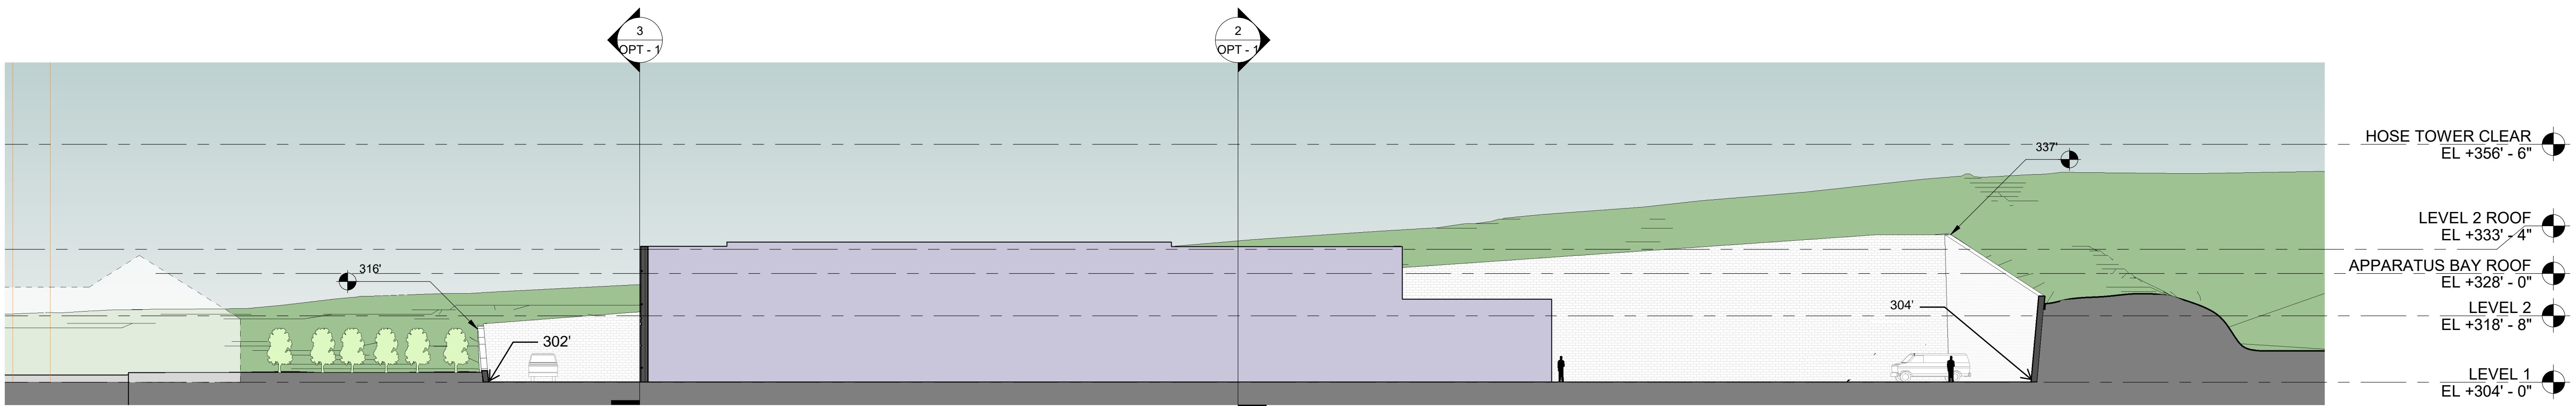

SECT. DD BATTERWALL SOUTH

1" = 20'-0"

1

BATTER AND TERRACE WALL OPTION - GEOGRID NOT ANTICIPATED FOR BATTER OPTION 3

PARE MARK-UP
2024-02-14
NOT FOR CONSTRUCTION

HKT
architects inc.

24 Roland Street,
Suite 301
Charlestown, MA 02129
T: 617.776.6545
F: 617.776.6678
www.hktarchitects.com

Revision Schedule		
Number	Revision	Date

Registrations

Consultants


PARE
PARE CORPORATION
ENGINEERS - SCIENTISTS - PLANNERS
10 LINCOLN ROAD, SUITE 210
FOXBORO, MA 02035
508-943-1755

Project
NORTHBOROUGH FIRE STATION
63 WEST MAIN STREET
TOWN OF NORTHBOROUGH, MA



GENERAL PLAN

AKL NC
Drawn by: 2/14/2024
Checked by:
Date: 23141.00 1" = 20'
Job number:
DRAFT ADVANCED SCHEMATIC DESIGN
Drawing set:

Drawing number
C-300

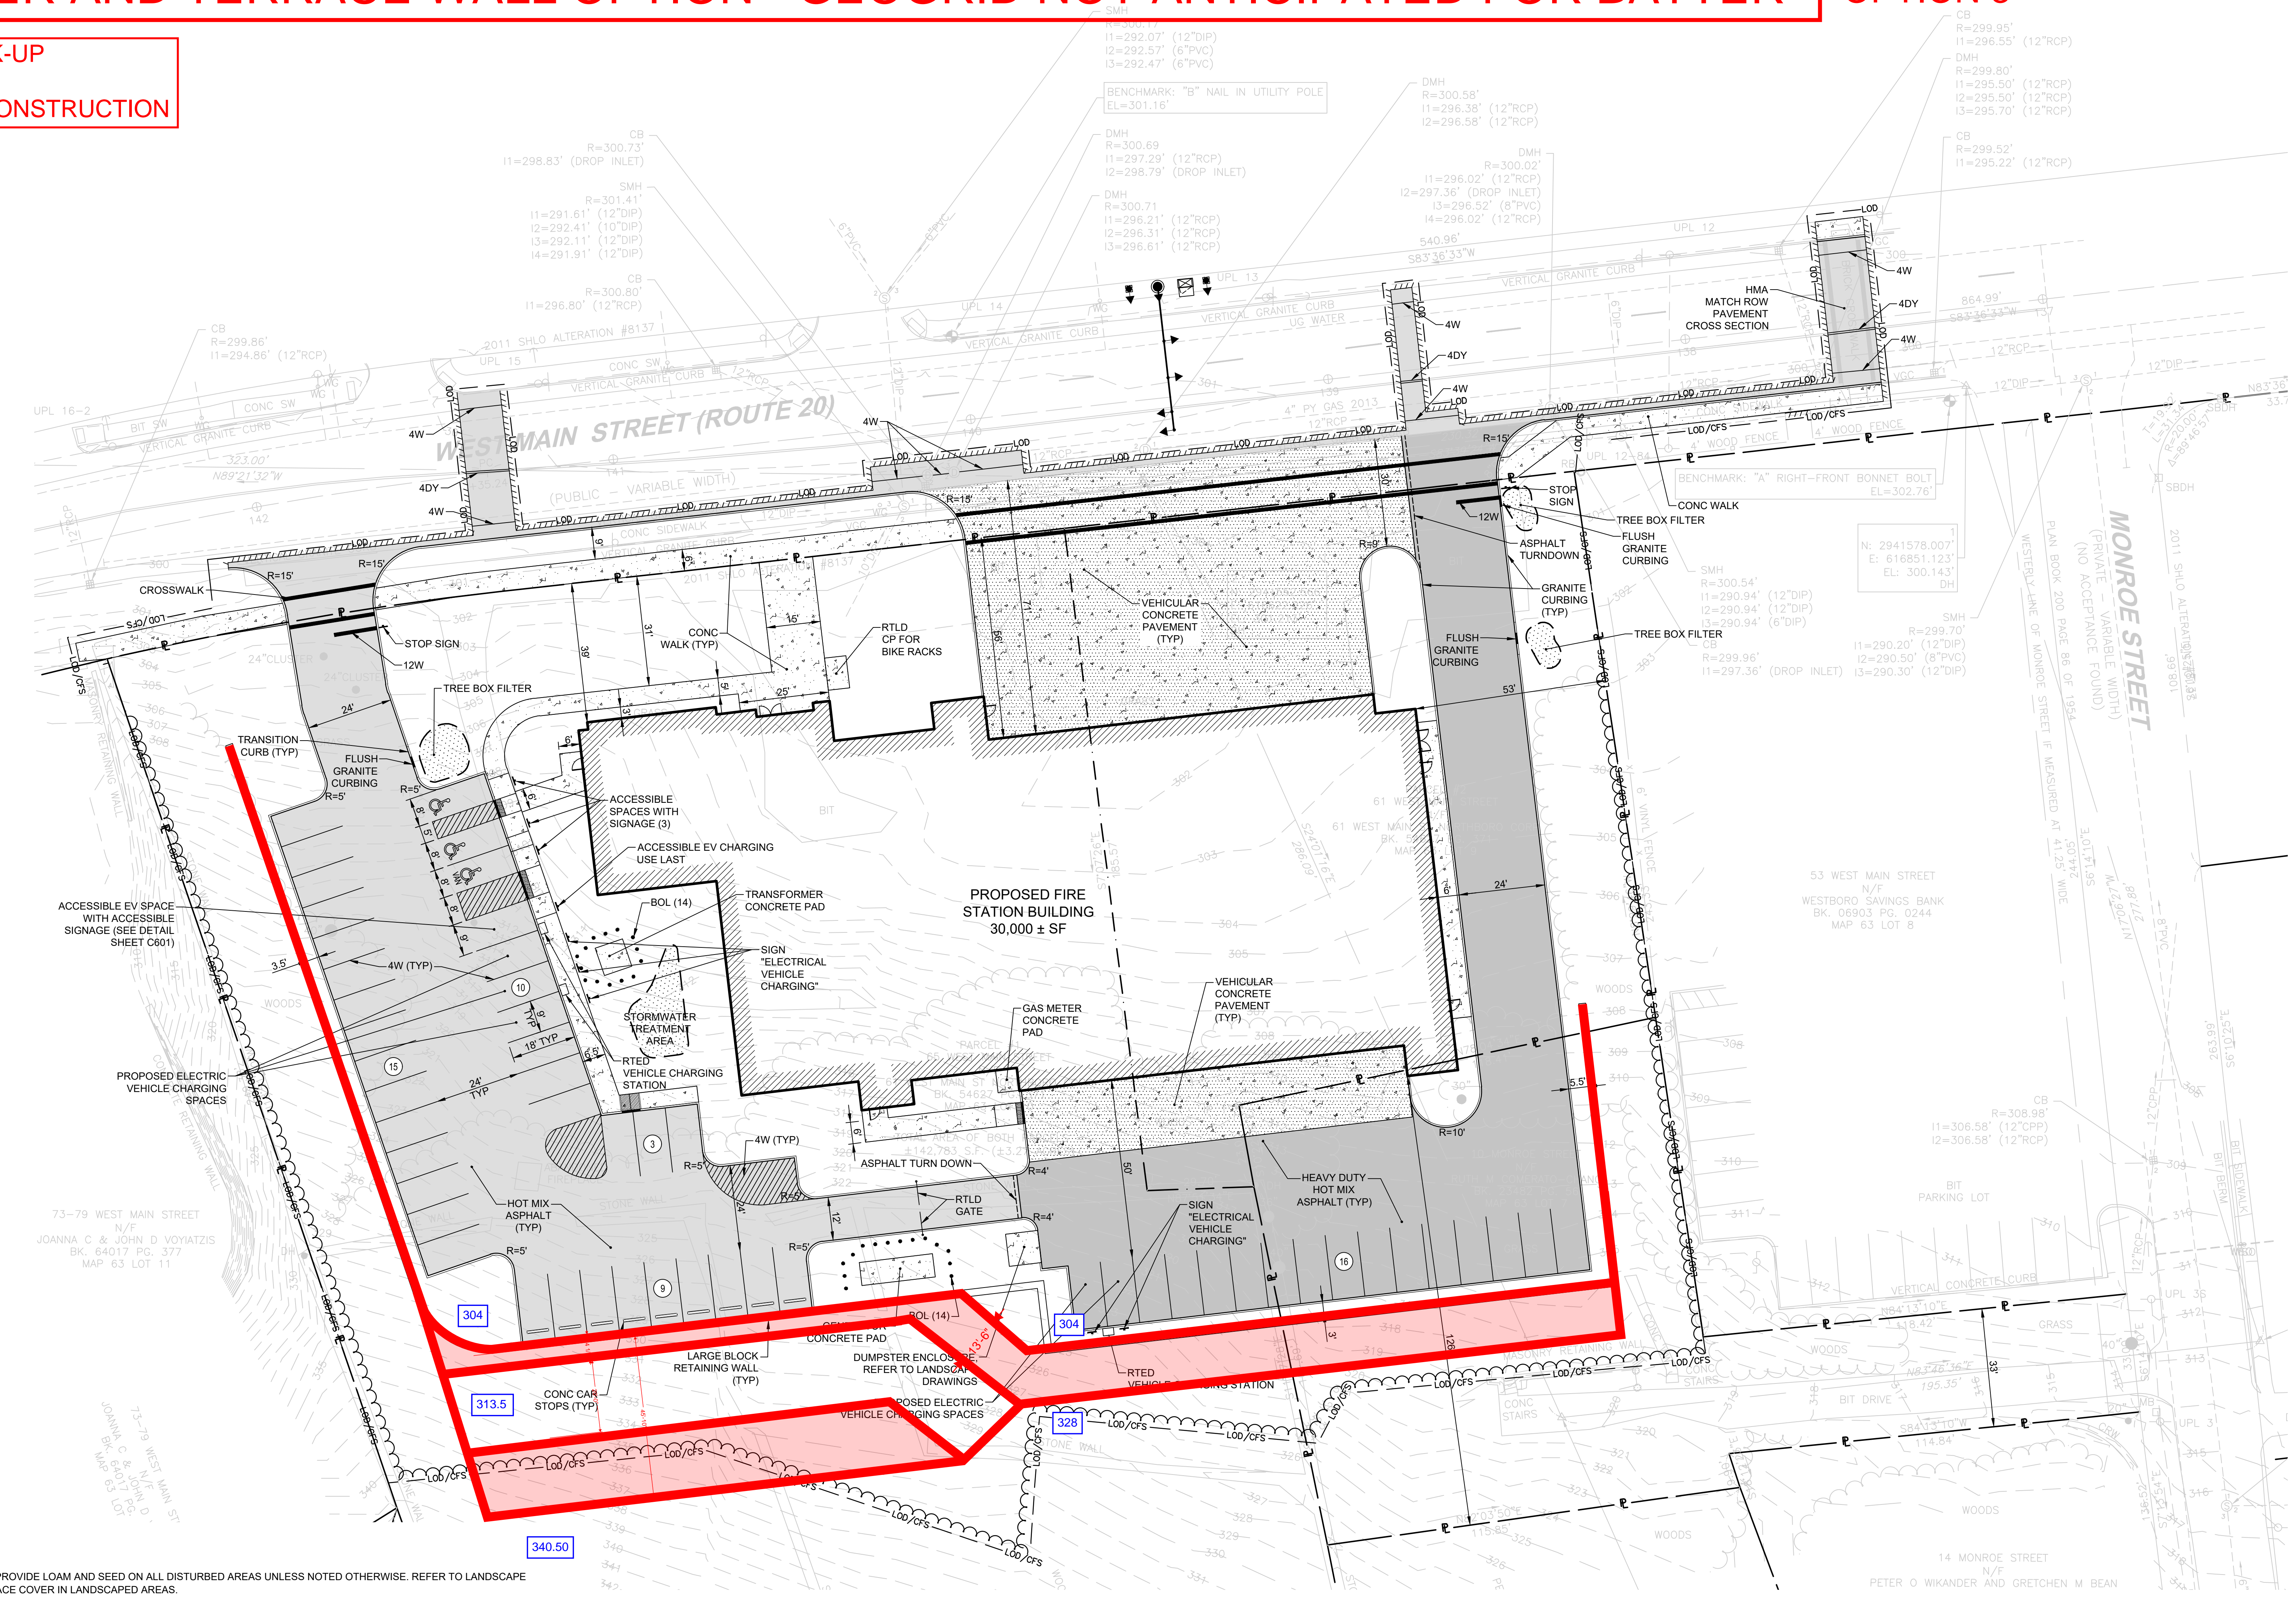

- NOTES:**
- CONTRACTOR SHALL PROVIDE LOAM AND SEED ON ALL DISTURBED AREAS UNLESS NOTED OTHERWISE. REFER TO LANDSCAPE DRAWINGS FOR SURFACE COVER IN LANDSCAPED AREAS.
 - ALL ACCESSIBLE RAMPS SHALL BE CONSTRUCTED WITH DETECTABLE WARNING PAVERS.
 - PRIOR TO COMMENCING WORK, THE CONTRACTOR SHALL EMPLOY A PROFESSIONAL LAND SURVEYOR REGISTERED IN THE STATE OF RHODE ISLAND TO ESTABLISH CONTROL ON THE SITE AND TO PERFORM FIELD MEASUREMENTS AS REQUIRED TO LAYOUT THE PROPOSED BUILDING AND SITE IMPROVEMENTS. THE CONTRACTOR'S SURVEYOR SHALL COORDINATE THE BUILDING LAYOUT WITH THE PROJECT LAND SURVEYOR TO ACCURATELY LOCATE THE BUILDING ON THE SITE.
 - REFER TO STRUCTURAL DRAWINGS FOR ALL CONCRETE ENTRANCE PADS.
 - REFER TO STRUCTURAL DRAWINGS FOR ALL TYPICAL SECTIONS OF ENTRY WAYS.
 - EXPANSION JOINTS (E.J.) 20 FEET O.C. (MAX.) UNLESS OTHERWISE NOTED.
 - CONTROL JOINTS (C.J.) 5 FEET O.C. (MAX.) UNLESS OTHERWISE NOTED.
 - ALL PARKING SPACES AND ISLANDS ARE TO BE MARKED WITH 4" THICK WHITE EPOXY PAVEMENT MARKING UNLESS NOTED OTHERWISE. WATERBORNE PAVEMENT MARKINGS ARE NOT ACCEPTABLE.
 - COORDINATE FINAL QUANTITY AND PLACEMENT OF BOLLARDS SURROUNDING TRANSFORMER WITH NATIONAL GRID.
 - COORDINATE FINAL QUANTITY AND PLACEMENT OF BOLLARDS SURROUNDING GENERATOR WITH ELECTRICAL DRAWINGS, UTILITY COMPANY, AND MANUFACTURER'S RECOMMENDATIONS.
 - COORDINATE ALL SIGN PLACEMENT AND SIZE WITH OWNER'S REPRESENTATIVE PRIOR TO INSTALLATION.
 - REFER TO "NOTES" FOR ADDITIONAL NOTES.

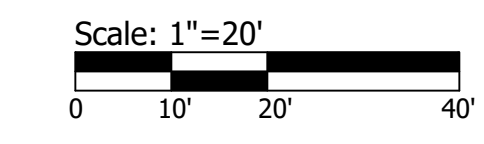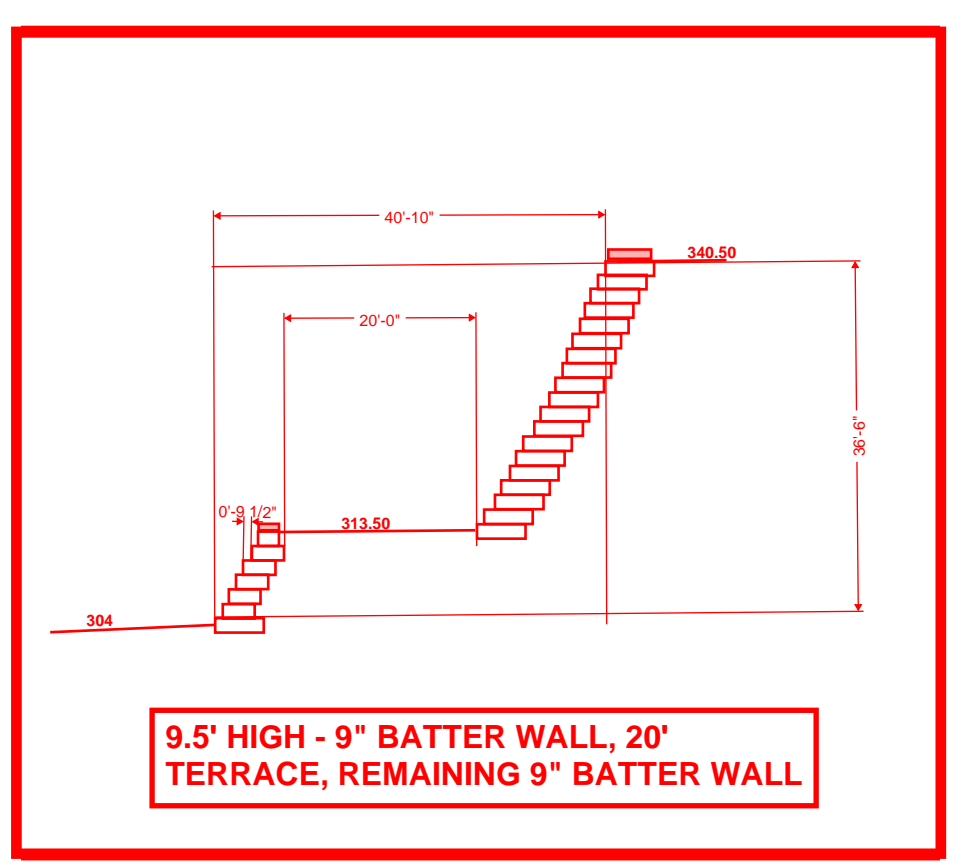

Revision Schedule		
NO.	Revision	Date

Registrations


Consultants

Project
NORTHBOROUGH FIRE STATION
63 WEST MAIN STREET
TOWN OF NORTHBOROUGH, MA

Drawing Title
BATTERWALL + TERRACE

Author
Drawn by
1/31/2024
Date
22314
Job number
SCHEMATIC DESIGN PRICING
Drawing set


Drawing number
OPT - 3

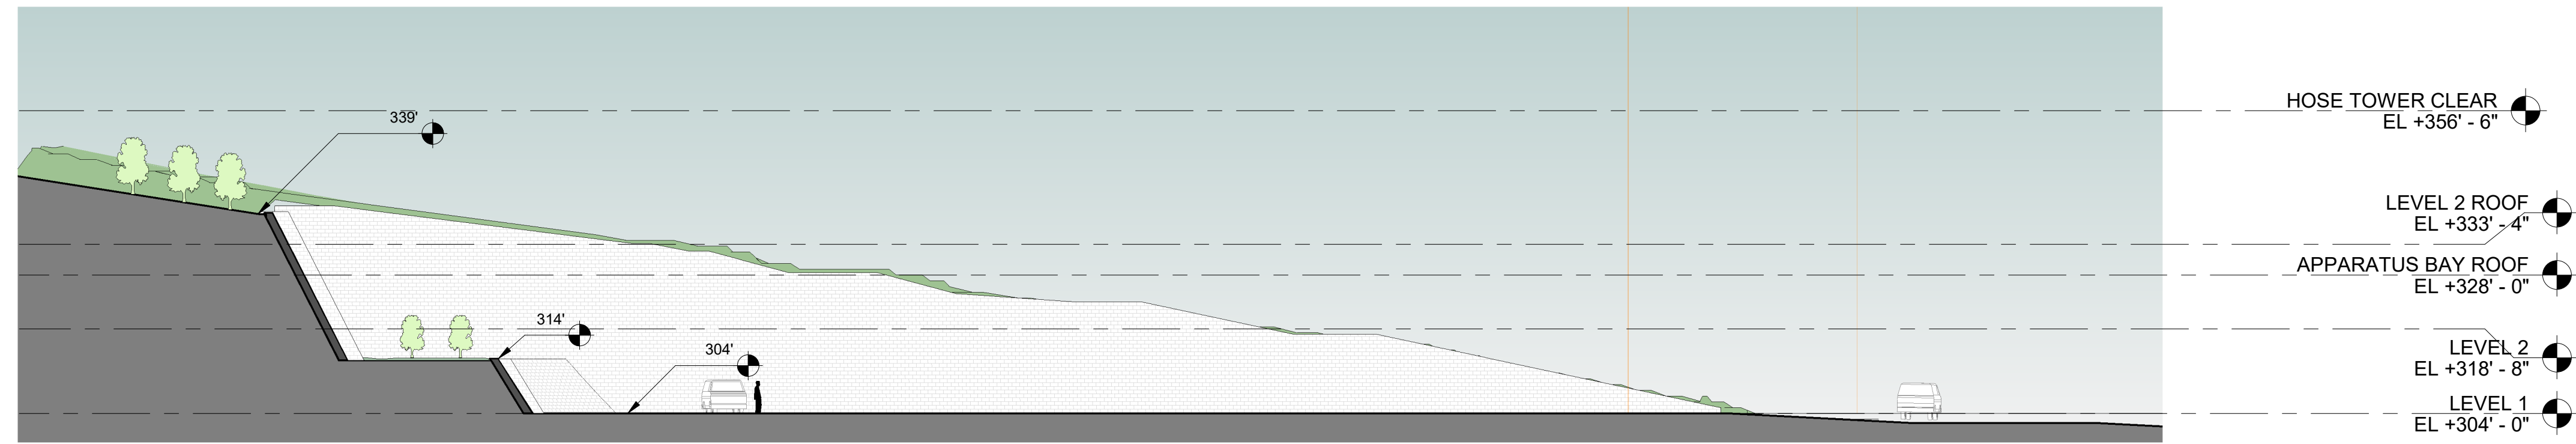

SECT. AA BATTERWALL + TERRACE WEST

1" = 20'-0"


4

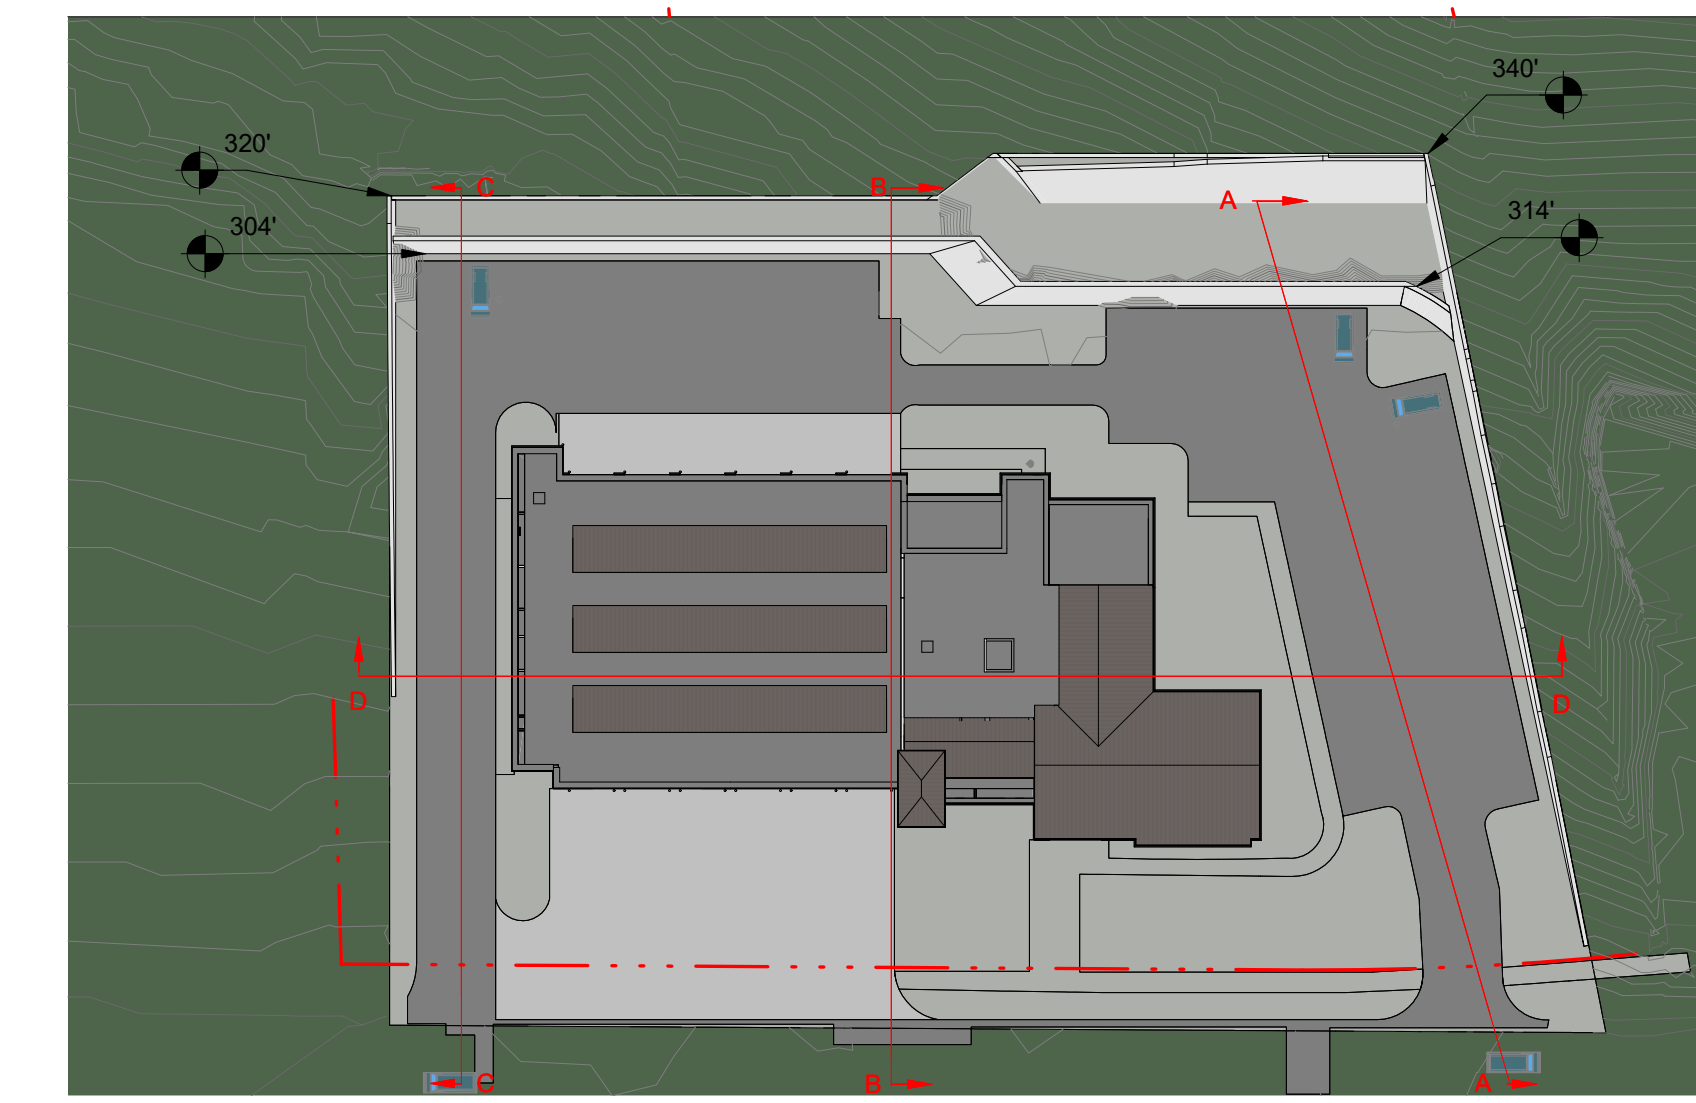

SITE PLAN OPTION 3 BATTERWALL + TERRACE

1" = 60'-0"


5

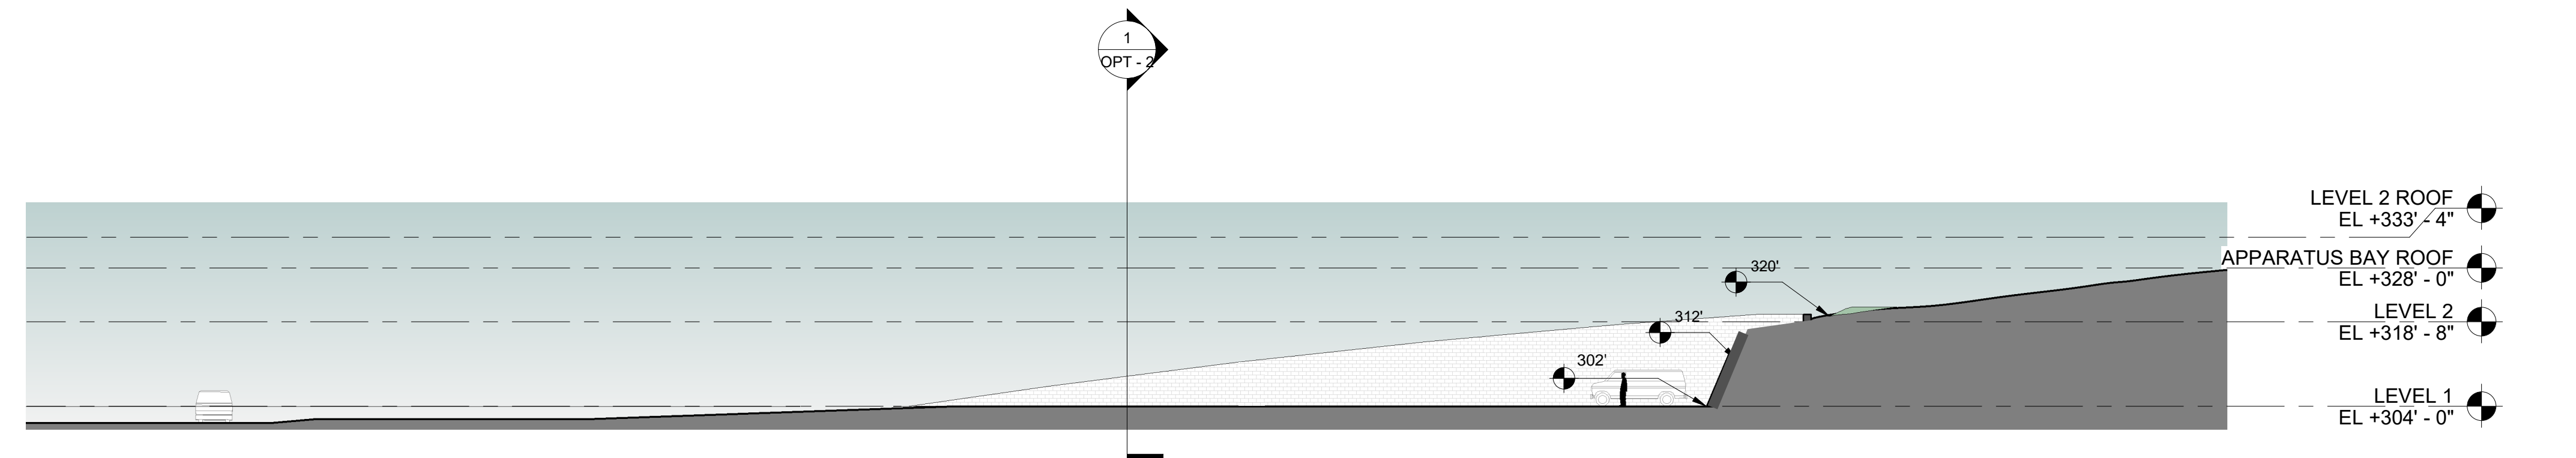

SECT. CC BATERWALL + TERRACE EAST

1" = 20'-0"


3

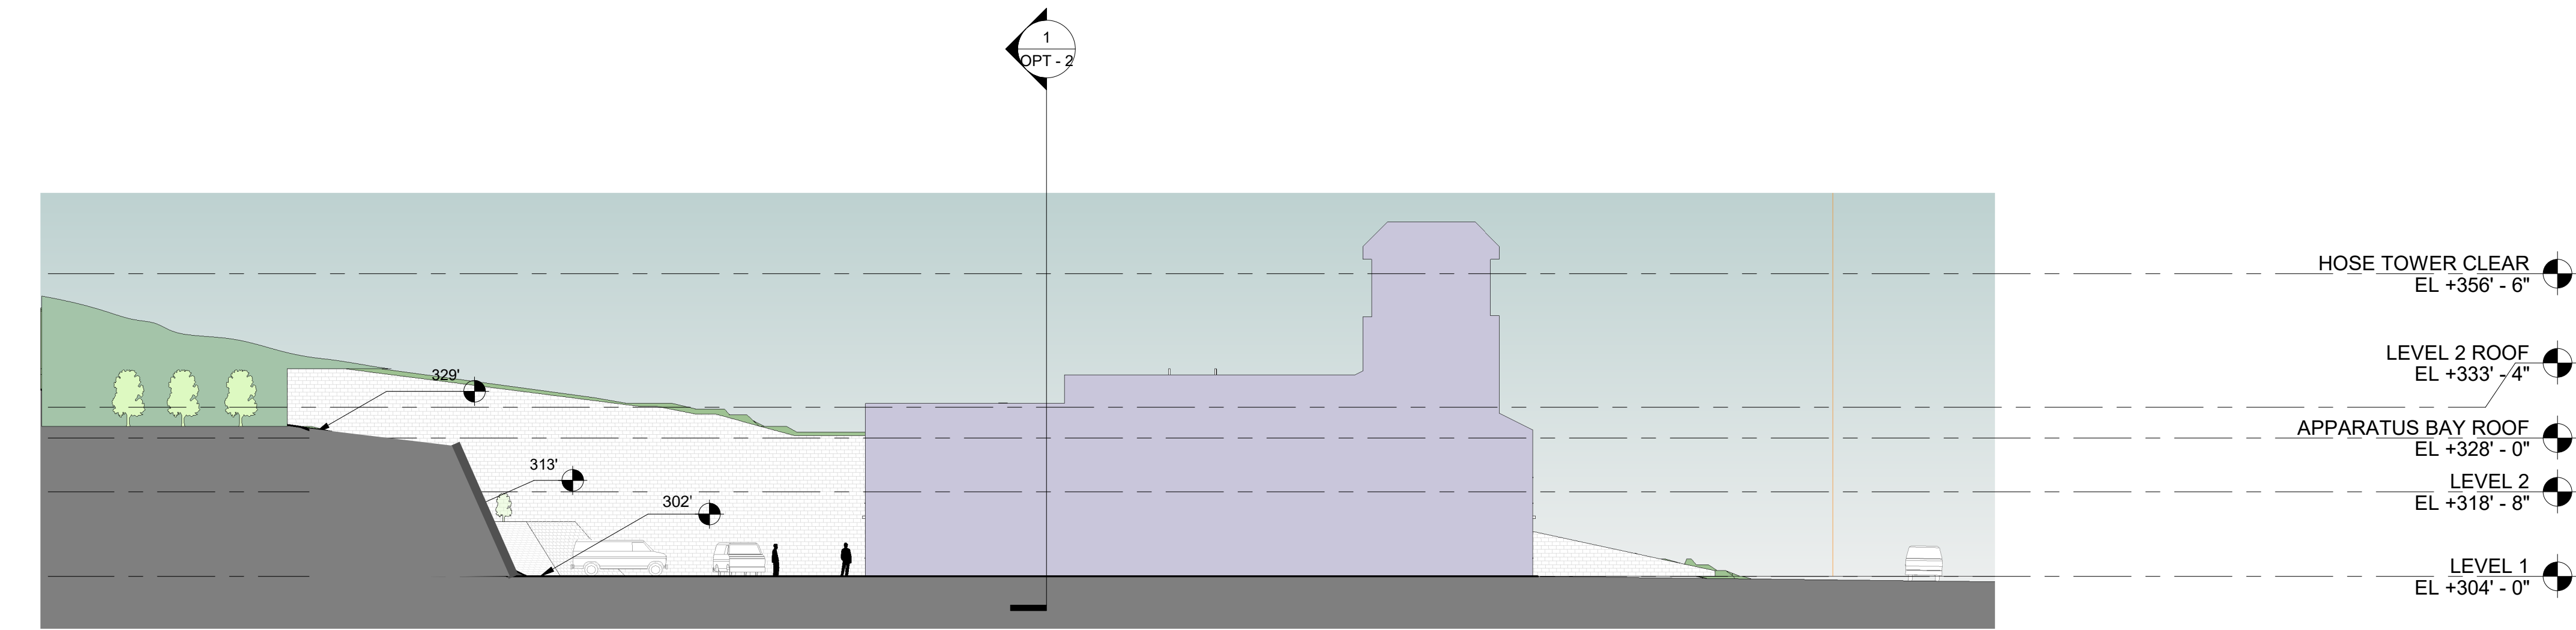

SECT. BB BATTERWALL + TERR MID

1" = 20'-0"

2

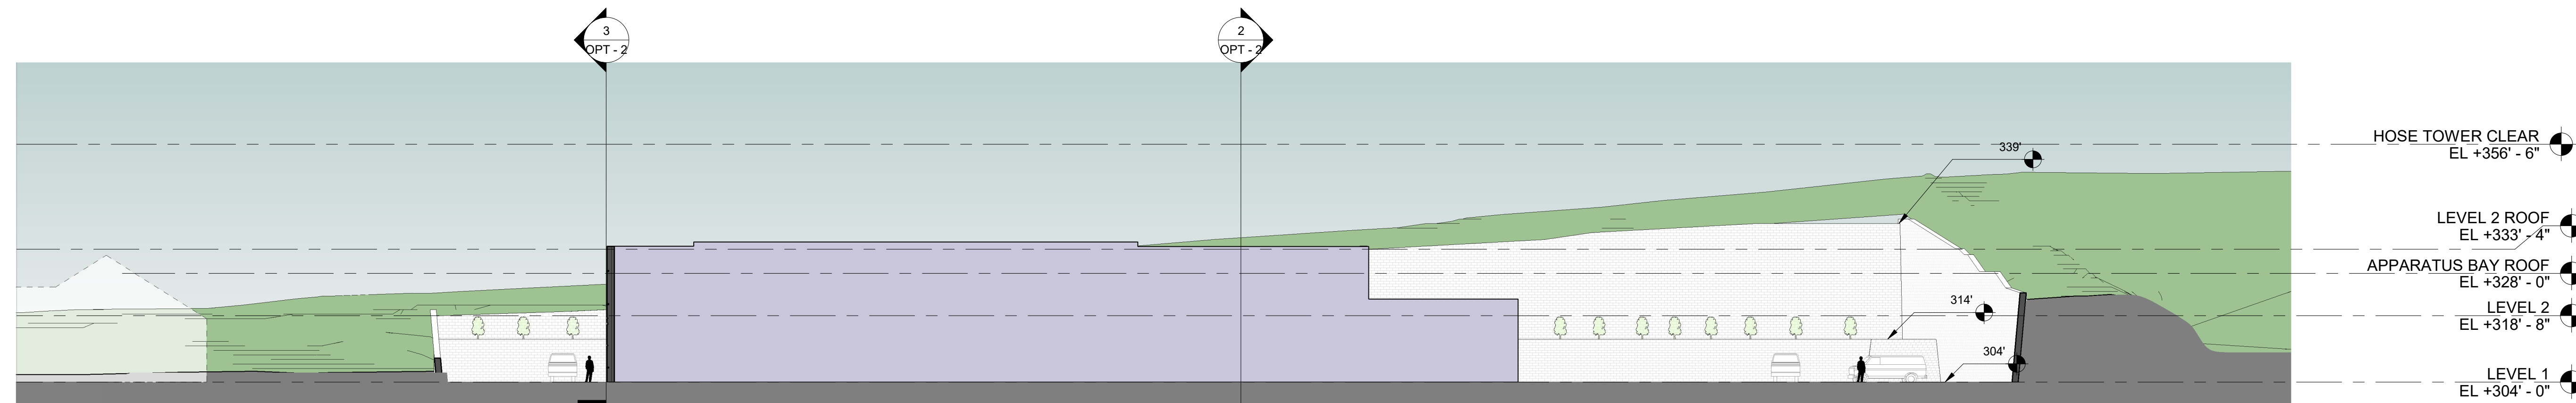


SECT. DD BATTERWALL+TERRACE SOUTH

1" = 20'-0"

1



2 TERRACE WALL OPTION - GEOGRID NOT REQUIRED FOR TERRACE OPTION 5

PARE MARK-UP
2024-02-14
NOT FOR CONSTRUCTION

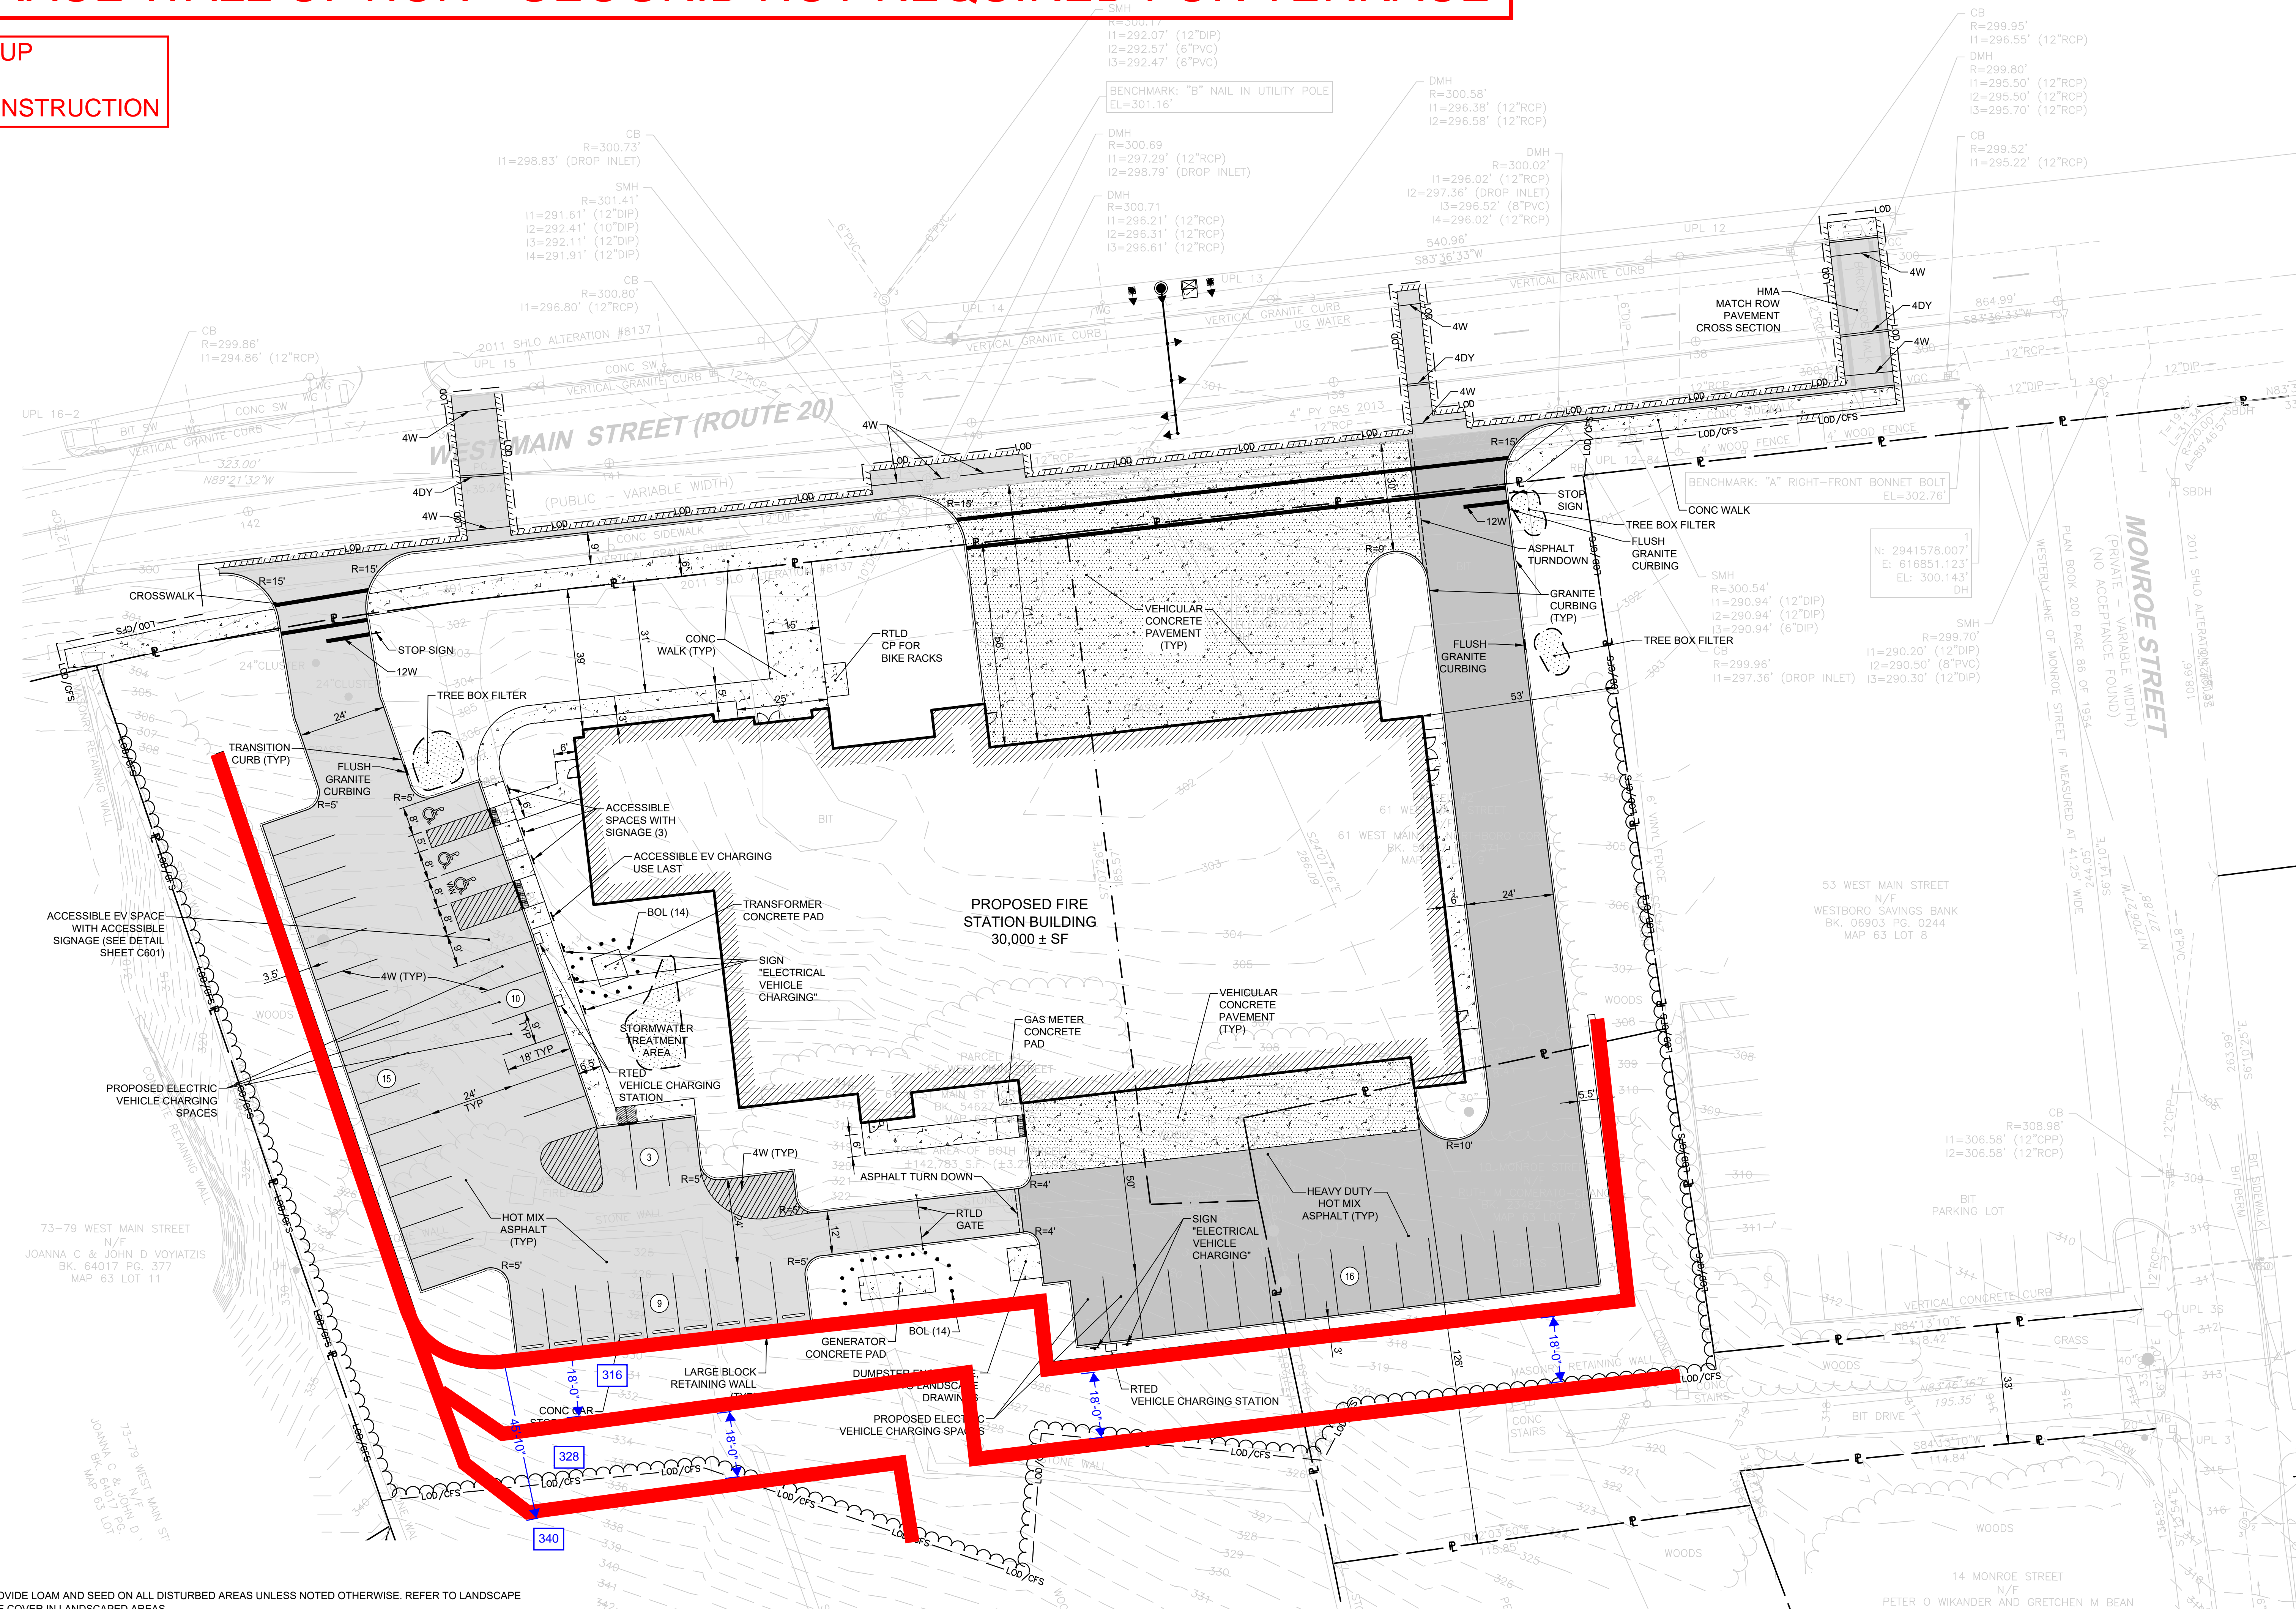

NOTES:

- CONTRACTOR SHALL PROVIDE LOAM AND SEED ON ALL DISTURBED AREAS UNLESS NOTED OTHERWISE. REFER TO LANDSCAPE DRAWINGS FOR SURFACE COVER IN LANDSCAPED AREAS.
- ALL ACCESSIBLE RAMPS SHALL BE CONSTRUCTED WITH DETECTABLE WARNING PAVERS.
- PRIOR TO COMMENCING WORK, THE CONTRACTOR SHALL EMPLOY A PROFESSIONAL LAND SURVEYOR REGISTERED IN THE STATE OF RHODE ISLAND TO ESTABLISH CONTROL ON THE SITE AND TO PERFORM FIELD MEASUREMENTS AS REQUIRED TO LAYOUT THE PROPOSED BUILDING AND SITE IMPROVEMENTS. THE CONTRACTOR'S SURVEYOR SHALL COORDINATE THE BUILDING LAYOUT WITH THE PROJECT LAND SURVEYOR TO ACCURATELY LOCATE THE BUILDING ON THE SITE.
- REFER TO STRUCTURAL DRAWINGS FOR ALL CONCRETE ENTRANCE PADS.
- REFER TO STRUCTURAL DRAWINGS FOR ALL TYPICAL SECTIONS OF ENTRY WAYS.
- EXPANSION JOINTS (E.J.) 20 FEET O.C. (MAX.) UNLESS OTHERWISE NOTED.
- CONTROL JOINTS (C.J.) 5 FEET O.C. (MAX.) UNLESS OTHERWISE NOTED.
- ALL PARKING SPACES AND ISLANDS ARE TO BE MARKED WITH 4" THICK WHITE EPOXY PAVEMENT MARKING UNLESS NOTED OTHERWISE. WATERBORNE PAVEMENT MARKINGS ARE NOT ACCEPTABLE.
- COORDINATE FINAL QUANTITY AND PLACEMENT OF BOLLARDS SURROUNDING TRANSFORMER WITH NATIONAL GRID.
- COORDINATE FINAL QUANTITY AND PLACEMENT OF BOLLARDS SURROUNDING GENERATOR WITH ELECTRICAL DRAWINGS, UTILITY COMPANY, AND MANUFACTURER'S RECOMMENDATIONS.
- COORDINATE ALL SIGN PLACEMENT AND SIZE WITH OWNER'S REPRESENTATIVE PRIOR TO INSTALLATION.
- REFER TO "NOTES" FOR ADDITIONAL NOTES.

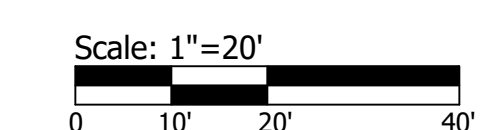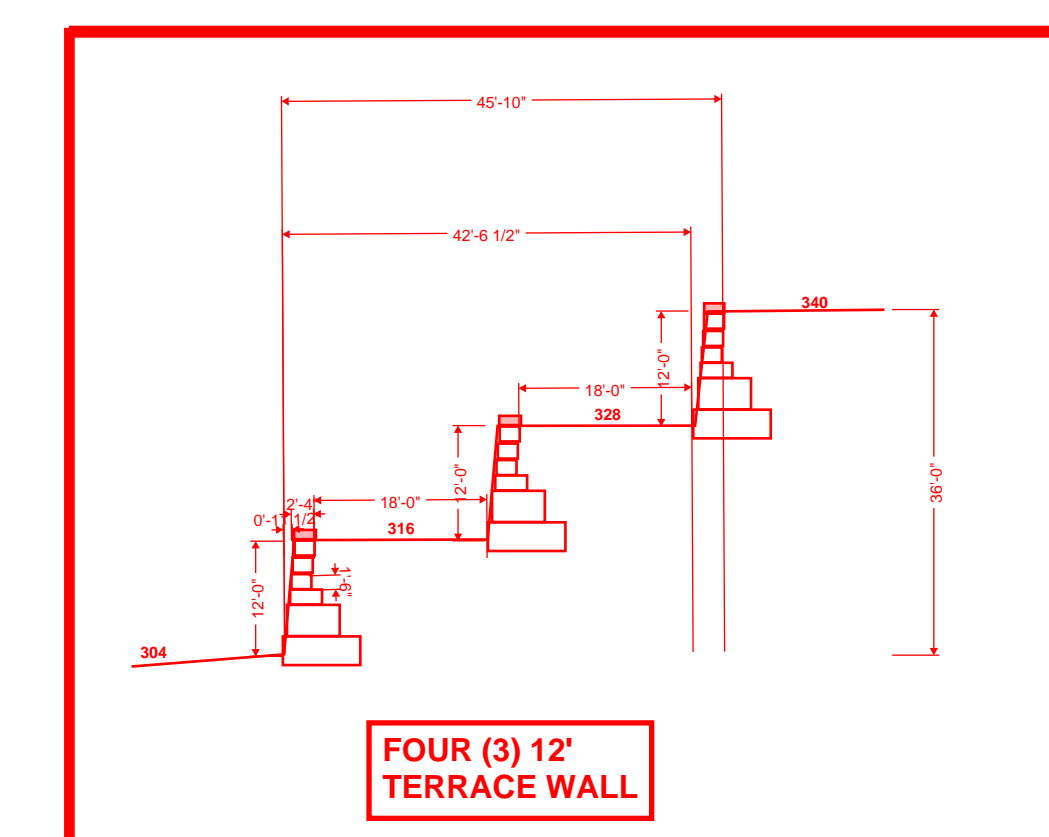

24 Roland Street,
Suite 301
Charlestown, MA 02129
T: 617.776.6545
F: 617.776.6678
www.hktarchitects.com

Revision Schedule		
Number	Revision	Date

Registrations

Consultants

PARE
PARE CORPORATION
ENGINEERS - SCIENTISTS - PLANNERS
10 LINCOLN ROAD, SUITE 210
FOXBORO, MA 02035
508-943-1755

Project
NORTHBOROUGH FIRE STATION
63 WEST MAIN STREET
TOWN OF NORTHBOROUGH, MA

GENERAL PLAN

AKL NC
Drawn by
2/14/2024
Date
23141.00 1" = 20'
Job number
DRAFT ADVANCED SCHEMATIC DESIGN
Drawing set

Drawing number
C-300

Revision Schedule		
NO.	Revision	Date


Registrations

Consultants

Project
NORTHBOROUGH FIRE STATION
 63 WEST MAIN STREET
 TOWN OF NORTHBOROUGH, MA


Drawing Title
TERRACE

Author Checker
 Drawn by Checked by
 1/31/2024
 Date
 22314
 Job number
 SCHEMATIC DESIGN PRICING
 Drawing set
 Drawing number
OPT - 5

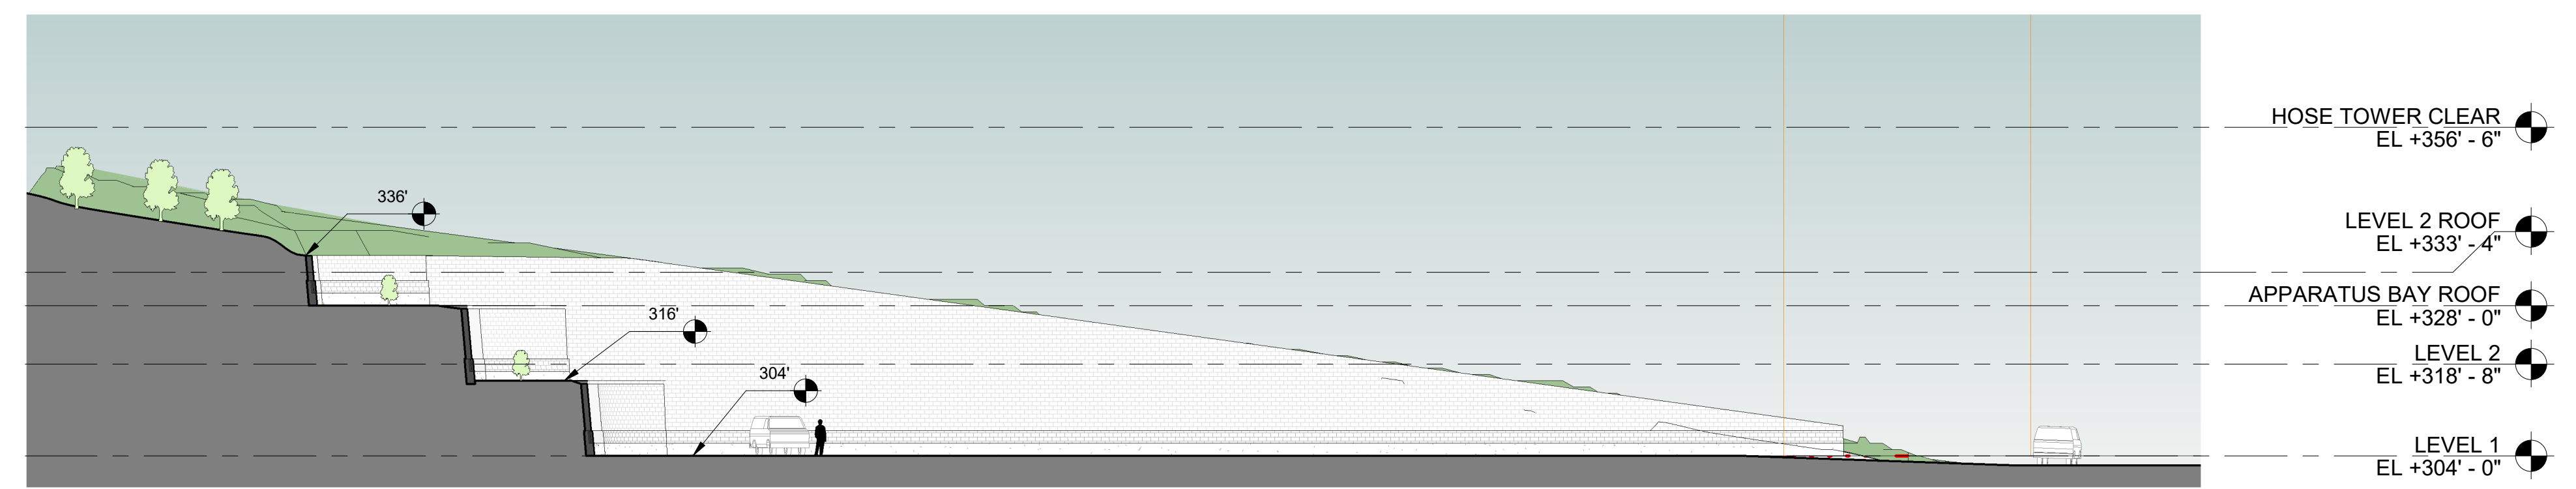


SECT. AA - TERRACED WEST
 1" = 20'-0"

4

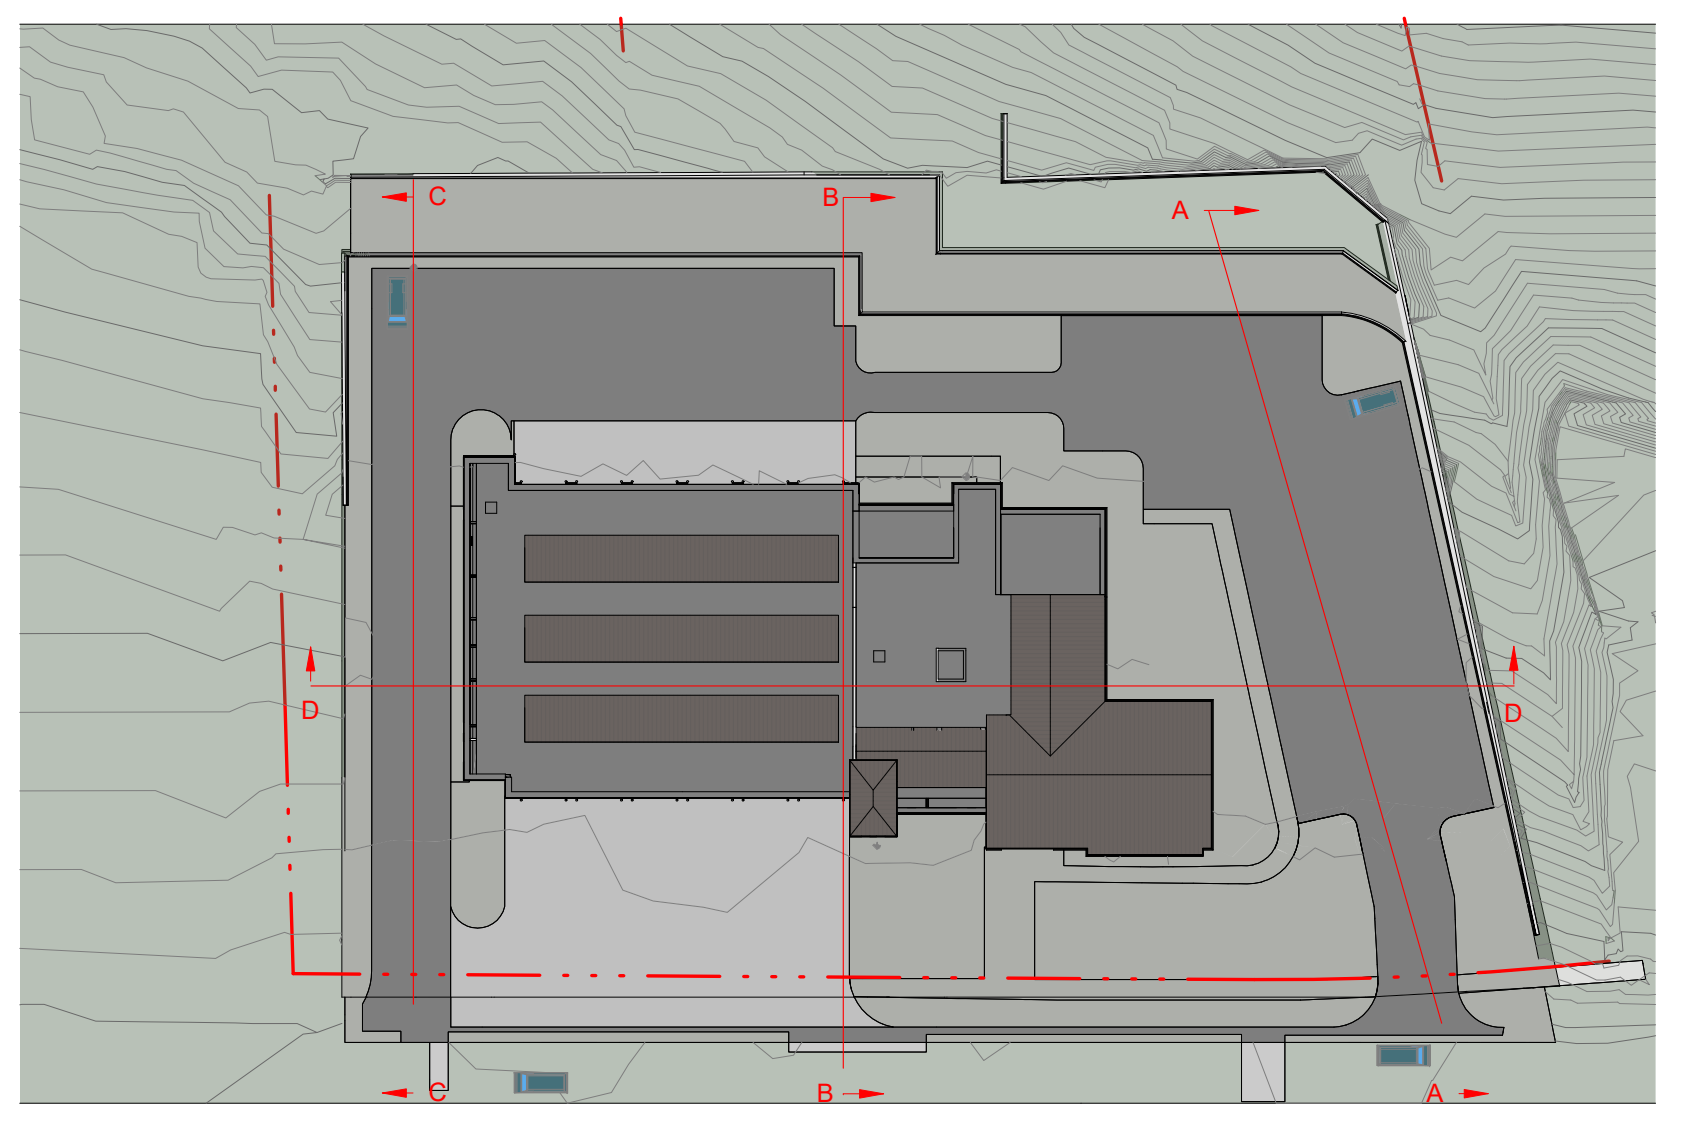


SITE PLAN OPTION 5 TERRACE
 1" = 60'-0"

5

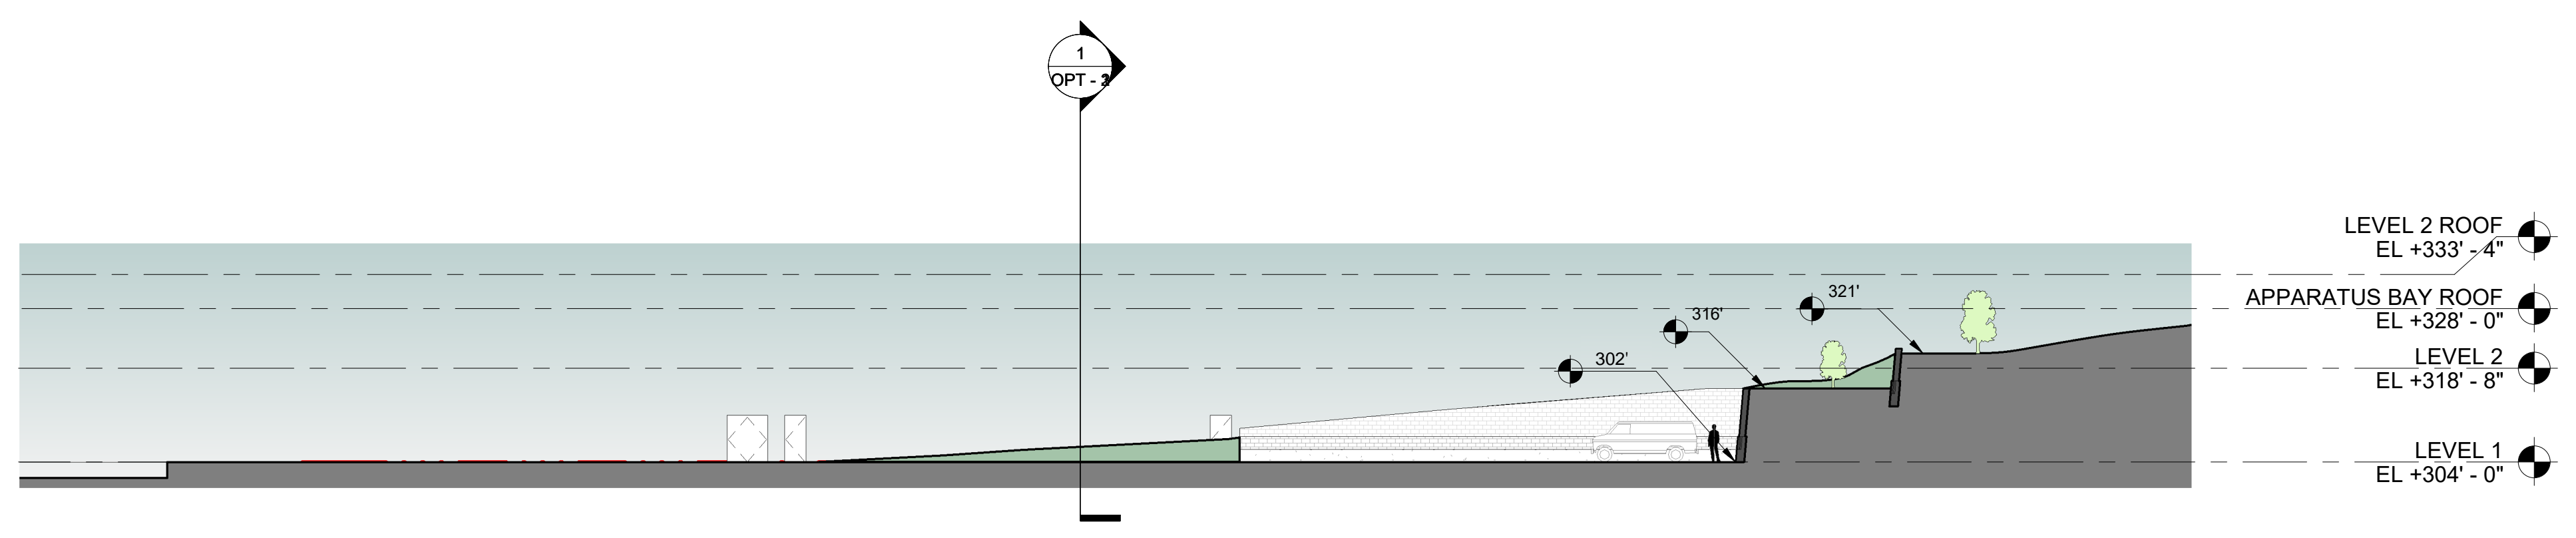


SECT. CC - TERRACED EAST
 1" = 20'-0"

3

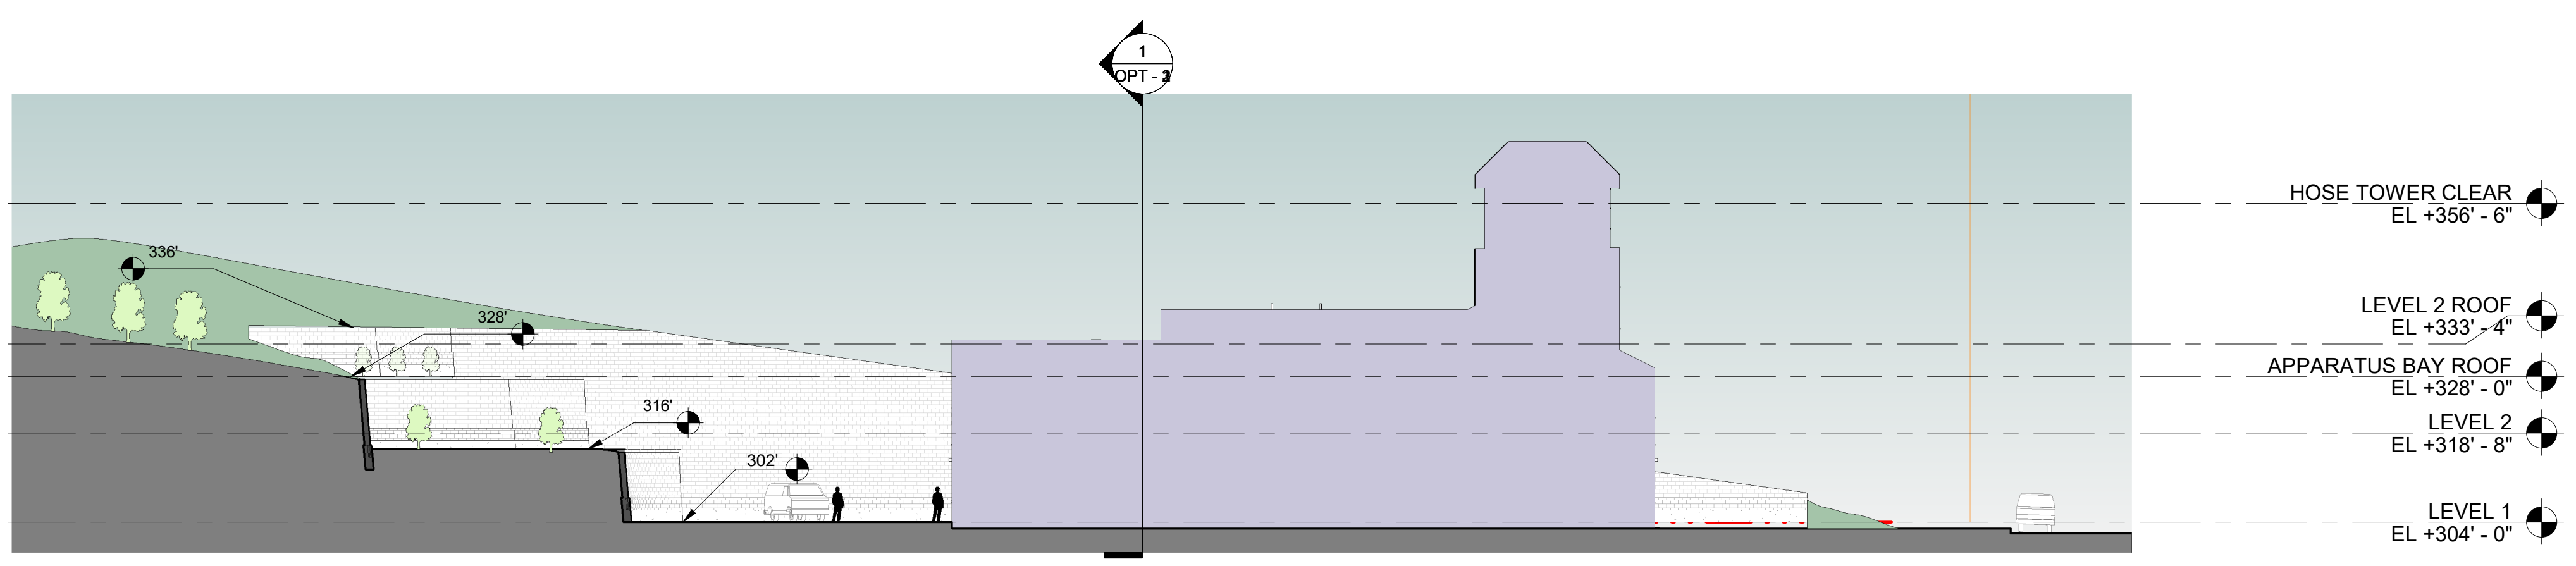

SECT. BB - TERRACED MID
 1" = 20'-0"

2

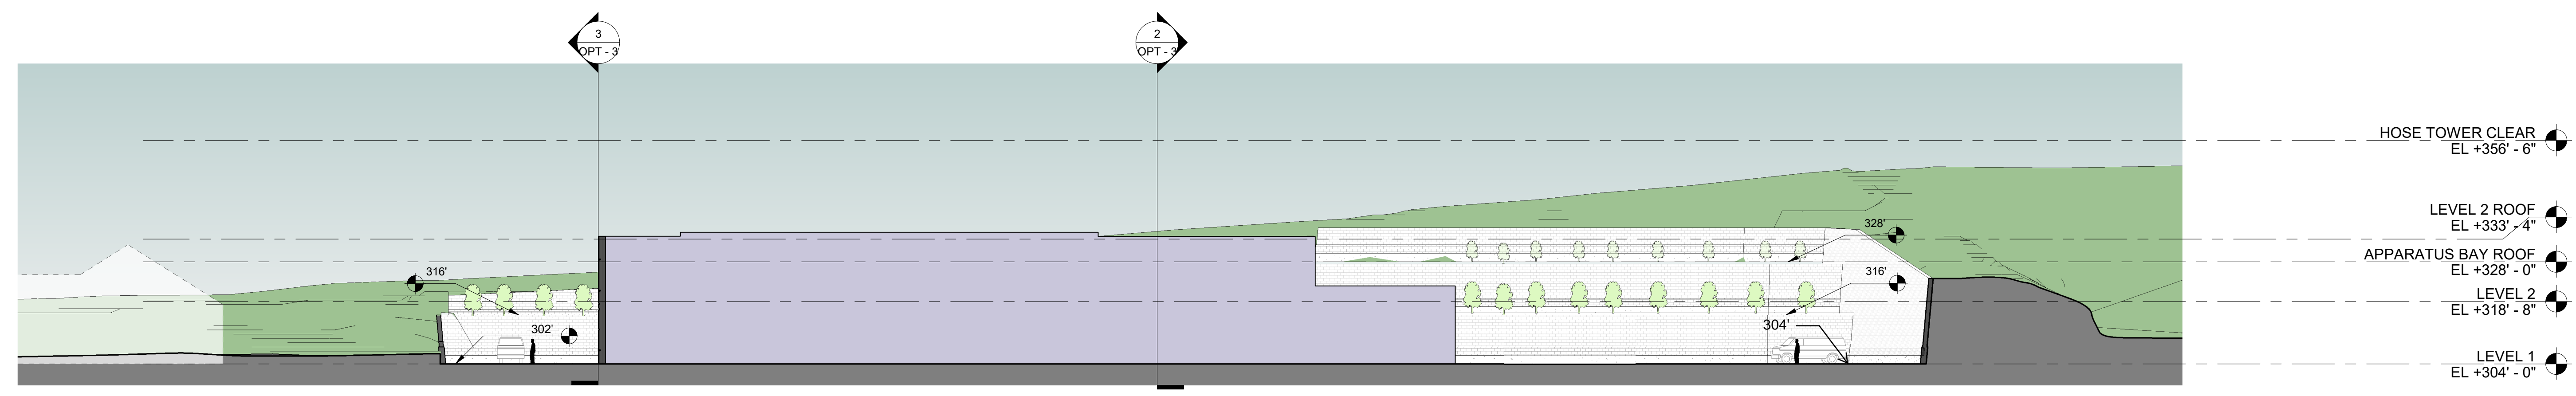

SECT. DD - TERRACED SOUTH
 1" = 20'-0"

1